


# SITE PLAN SUBMITTAL FORM

<b>OWNER NAME:</b> Susan Lorincz	<b>Map and Taxlot #:</b> 18-03-09-5700	<b>APPLICANT NAME:</b> _____
<b>PHONE #</b> 515-5770	_____	<b>PHONE #</b> _____
<b>ADDRESS:</b> 2899 E 40TH EUGENE OREGON	<b>Scale:</b> 1" = 60' (11" x 17")	<b>ADDRESS:</b> _____



T18S R03W SECTION 09

LMD staff can NOT be held responsible for evaluations based on false, inaccurate or incomplete information

BP# 09-0247  
 PLANNING SETBACKS O.K.  
 DATE 3/24/09  
 INITIALS SYE

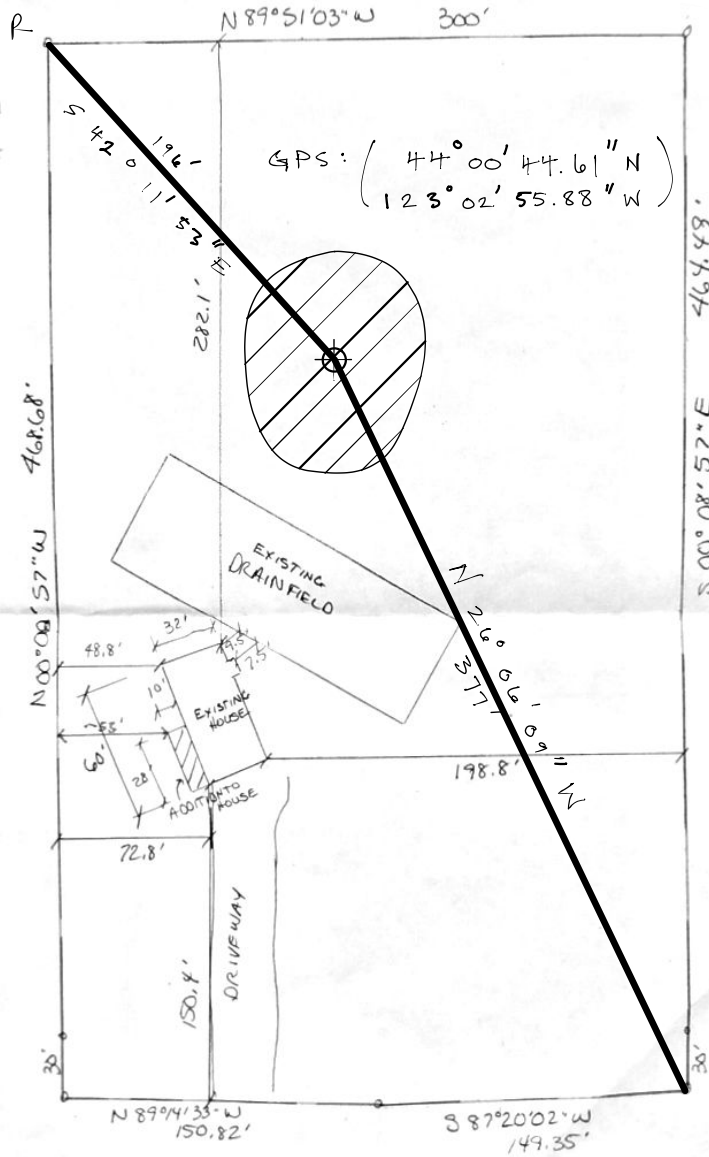

OVERVIEW

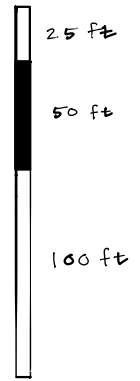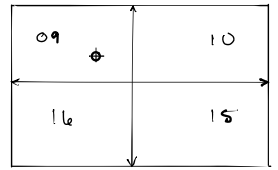

3.27 ACRES

E. 40TH AVE

- CENTER OF EXISTING RESERVOIR IS 133' E AND 146' S OF REF. CORNER (NW) DENOTED R.
- POND IS FED BY GROUNDWATER AND RUNOFF. NO STREAM, DIVERSION OR DAM PRESENT.
- GPS LOCATION IS 415' N AND 435' W FROM PLSS CORNER OF SECTIONS 09, 10, 15, AND 16 (SEE OVERVIEW).