

JAVIER FONSECA
5433 WEST SIDE RD
CAVE JUNCTION, OR 97523

CLAIM OF BENEFICIAL USE

APPLICATION G-18373
PERMIT G-17885

SITUATED IN
SECTION 29, TOWNSHIP 39 S
RANGE 8 W, W.M.
JOSEPHINE COUNTY OREGON

LEGEND

● JOSE 55408 and METER
(JOSE 57019 ALTERATION)
1300' NORTH 350' EAST
OF SW CORNER
SECTION 29, T39S R8W

▨ PLACE OF USE
3.0 ACRES
SW SW SECTION 29


▲ TANKS

— PIPELINES



0 200 ft

This map is not intended to provide
legal dimensions or locations of
property ownership lines

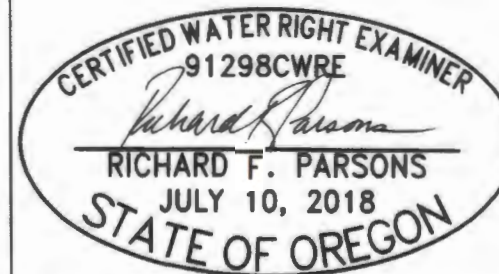

ParsonsWater Consulting LLC
rick.parsons@parsonwater.com
541.499.0257 303.667.5067

RECEIVED
JUL 03 2023
OWRD