

T35S R1E & T36S R1E WM, JACKSON COUNTY, OR



0 1,320 Feet


1" = 1320'

Well Locations:


#1 (JACK 54961/L-151815): 110' N, 1330' W of SE Cor Sec 6

#3 (JACK 63111/L-126758): 1600' N, 2320' W of SE Cor Sec 6

#7 (JACK 63110/L-126759): 1050' S, 1130' W of NE Cor Sec 6

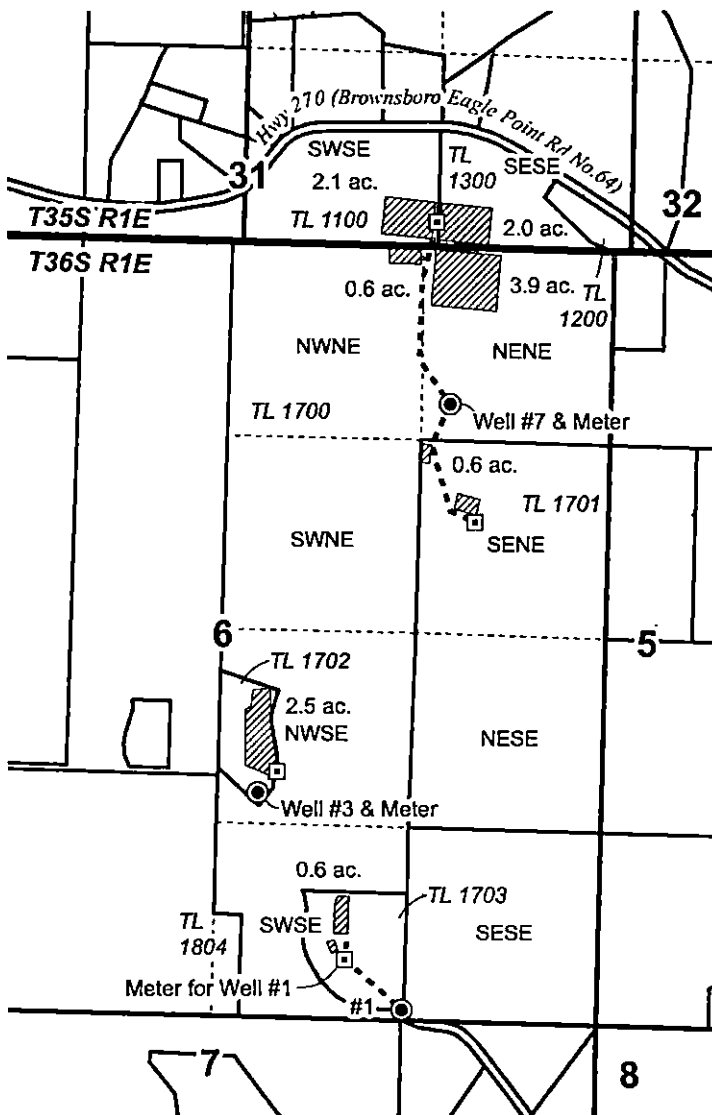

- Well
- Bulge - Storage Tank
- Pipeline
- ▨ POU NU
- Township
- Section
- Quarter Quarter
- Tax Lot

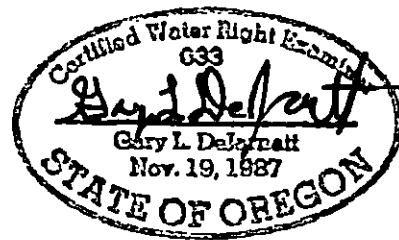

RENEWAL DATE 12/31/2023

RECEIVED

JUL 17 2023

30, 21



Date: 6/24/2023

**CLAIM OF BENEFICIAL USE MAP
Butte Creek Ranch, LLC**

Project #23024

Ap G-18388 Permit G-17831

This map is not intended to provide legal dimensions or locations of property ownership lines.

WATER RIGHT SERVICES, LLC
PO BOX 1830, BEND, OR 97709
WWW.OREGONWATER.US CCB # 197121
johnshort@usa.com 541-389-2837