

Claim of Beneficial Use Map in the name of Pete Swan


Application G-18919; Permit G-18496

Polk County, Oregon
Township 9 South, Range 4 West (W.M.)

RECEIVED

JUL 20 2023

OWRD
SALEM, OREGON

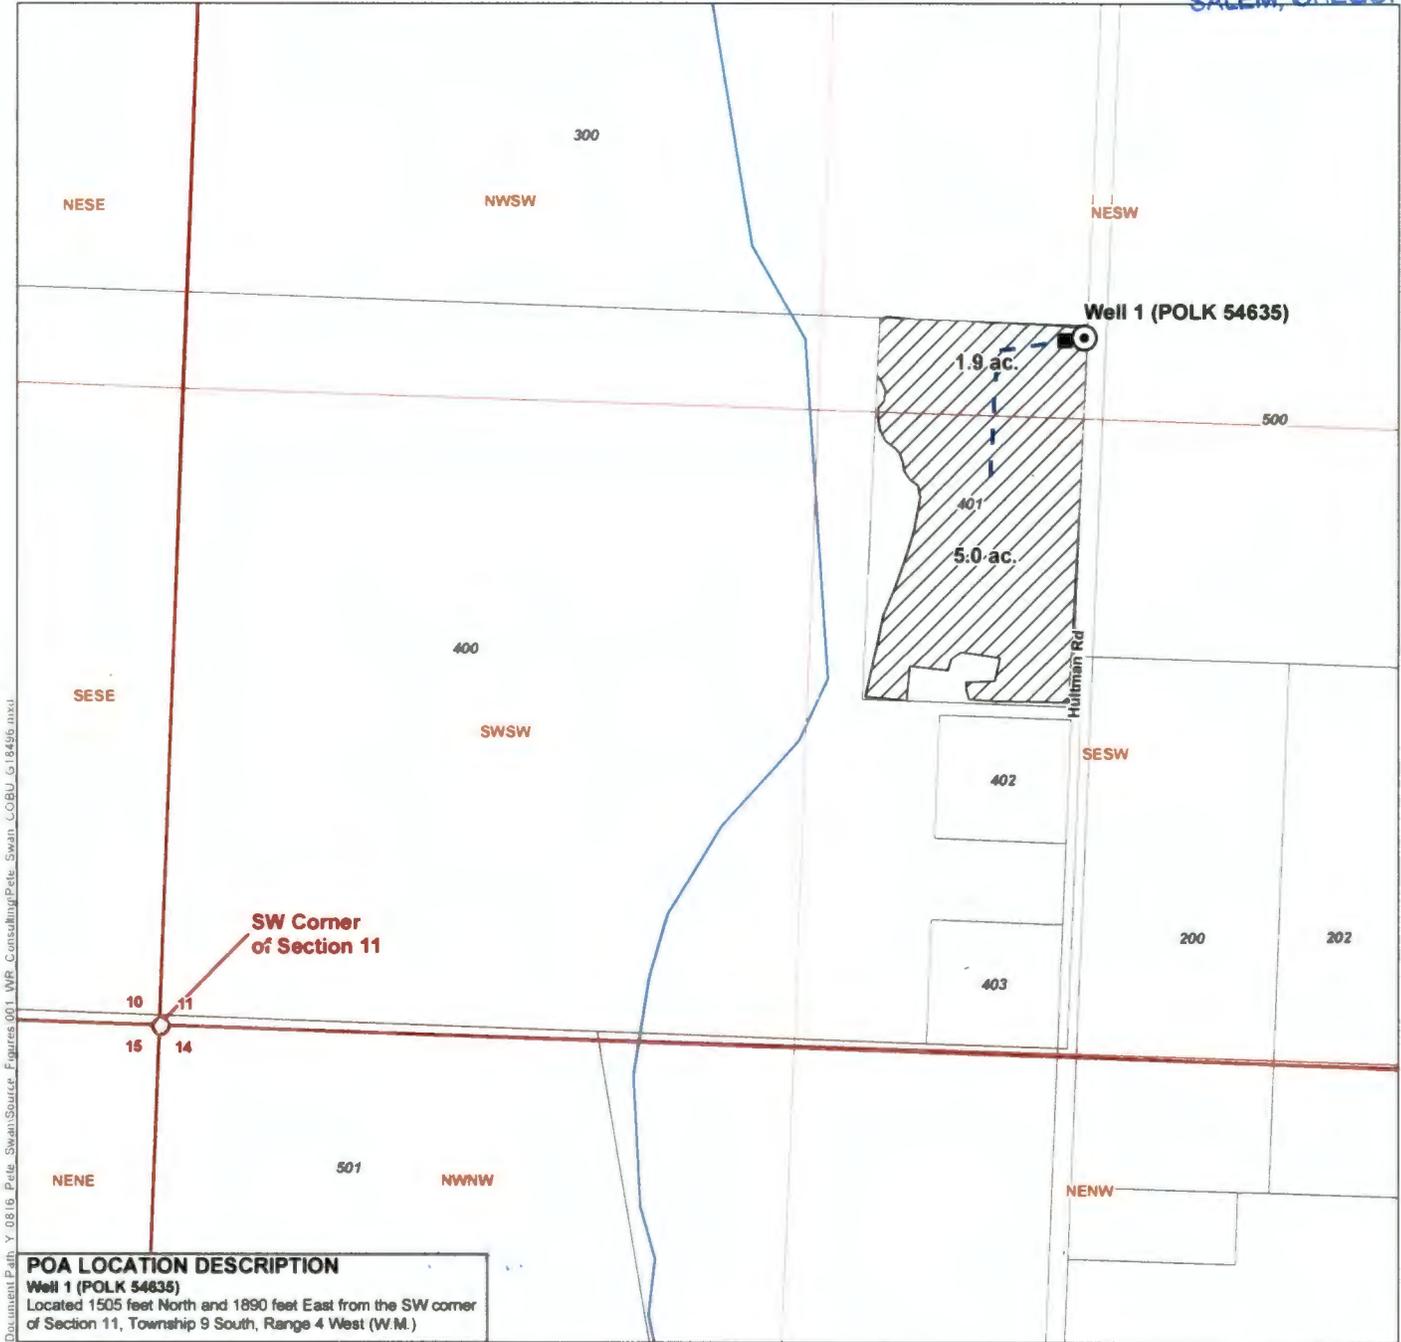

Document Path: Y:\0816_Pete_Swan\Source_Figures\001_WR_Consulting\Pete_Swan_COBU_G18496.mxd

POA LOCATION DESCRIPTION
Well 1 (POLK 54635)
 Located 1505 feet North and 1890 feet East from the SW corner of Section 11, Township 9 South, Range 4 West (W.M.)

- LEGEND**
- ⊙ Point of Appropriation (POA)
 - Meter
 - Mainline
 - ▨ Place of Use (POU)
 - Government Lot (GL)
 - All Other Features**
 - Tax Lot
 - ~ Watercourse
 - Waterbody

Certified Water Rights Examiner Stamp

CERTIFIED WATER RIGHTS EXAMINER
 #94217CWRE
Robyn C. Cook
 ROBYN C. COOK
 MAY 16, 2019
 STATE OF OREGON
 RENEWS: 12-31-2023

DISCLAIMER
 This map was prepared for the purpose of identifying the location of a water right only and it is not intended to provide legal dimensions or location of property ownership lines

MAP NOTES
 Date: June 16, 2023
 Data Sources: USGS, BLM, OWRD, ESRI

0 200 400

1 inch = 400 feet