


- Well
- ▣ Bulge-in-System
- ⊙ Meter



**T34S R1E, WM,
JACKSON COUNTY, OR**

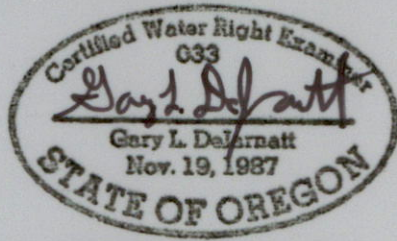


1" = 400'



RENEWAL DATE 12/31/2023

- ▨ POU IR
- Section
- Tax Lot
- ▨ POU Pond Maintenance and Storage for Fish Life, Wildlife, & Recreation

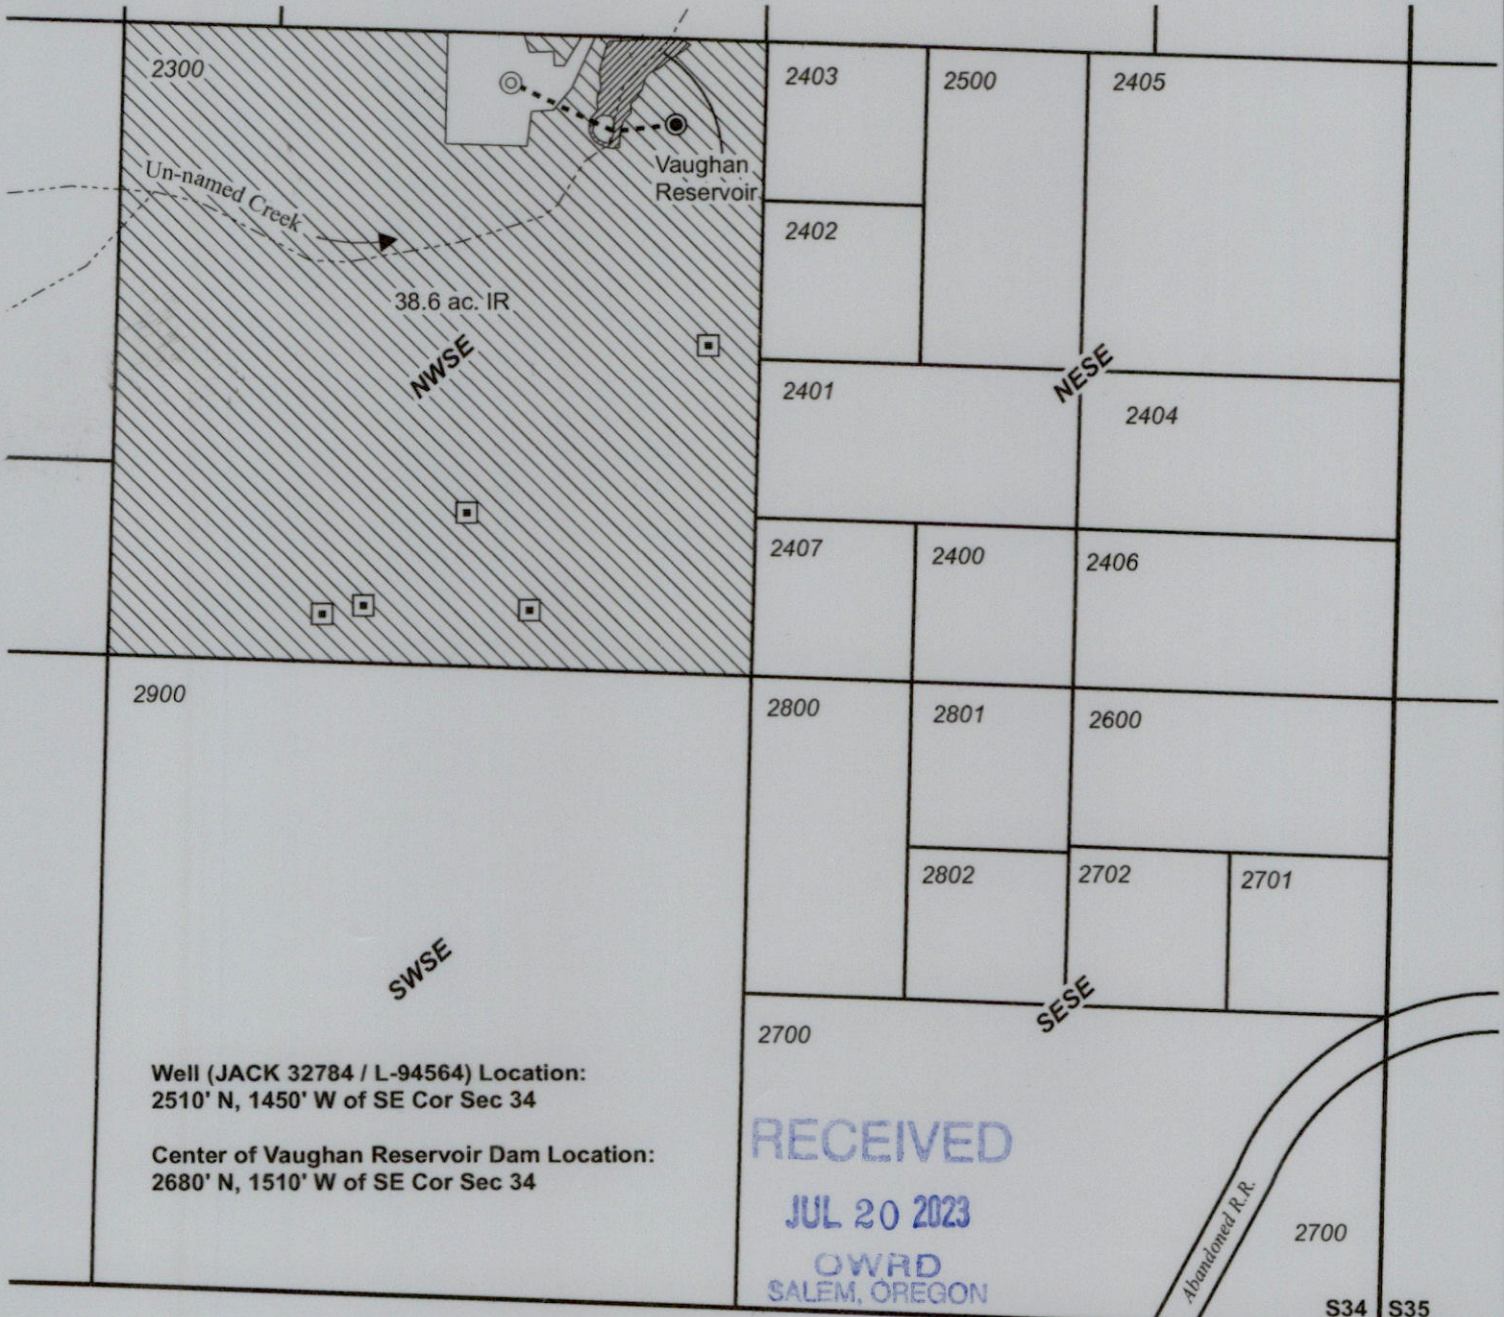

Well (JACK 32784 / L-94564) Location:
2510' N, 1450' W of SE Cor Sec 34

Center of Vaughn Reservoir Dam Location:
2680' N, 1510' W of SE Cor Sec 34

RECEIVED
JUL 20 2023
OWRD
SALEM, OREGON

S34 S35
S3 S4

CLAIM OF BENEFICIAL USE MAP
Shad Vaughan Project #23025

Date: 6/6/2023

Ap G-18353 / Permit G-17851

This map is not intended
to provide legal dimensions
or locations of property
ownership lines.

WATER RIGHT SERVICES, LLC
PO BOX 1830, BEND, OR 97709
WWW.OREGONWATER.US CCB # 197121
johnshort@usa.com 541-389-2837