


RECEIVED

JUL 24 2023

OWRD

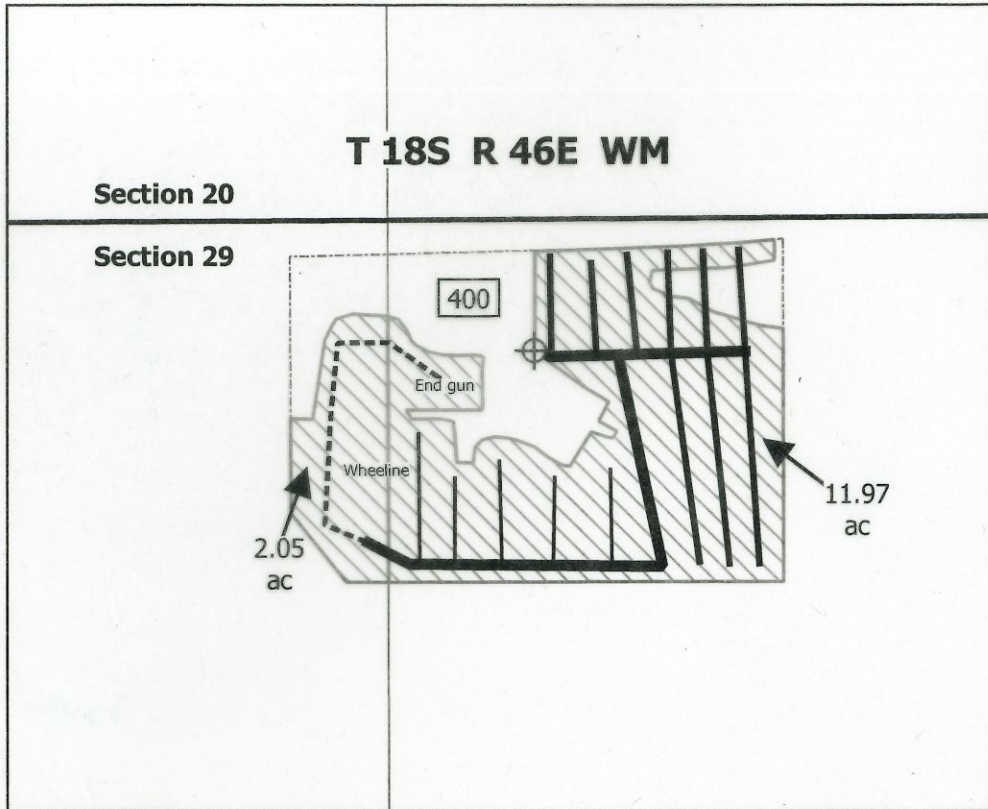

LEGEND

- Well
- Place of Use
- Malheur County Property Boundary 400
- 2" Lateral
- 3" Handline
- 3" Lateral
- 4" Mainline



Claim of Beneficial Use Map
Application G-18654, Permit G-18247
Malheur County, OR

Prepared on behalf of Vern and Amelia Keffer

1 inch = 400 feet



Date: 7/21/23
Drawn by: Paul F. Garvin

Notes:

Well 2 (L-126977): 330' South and 2,226' East from the NE corner of Section 29

Flow measurement device located within a 5 foot radius of Well 2

This map is not intended to provide legal dimensions or locations of property ownership lines.