


RECEIVED

AUG 02 2023
OWRD
SALEM, OREGON

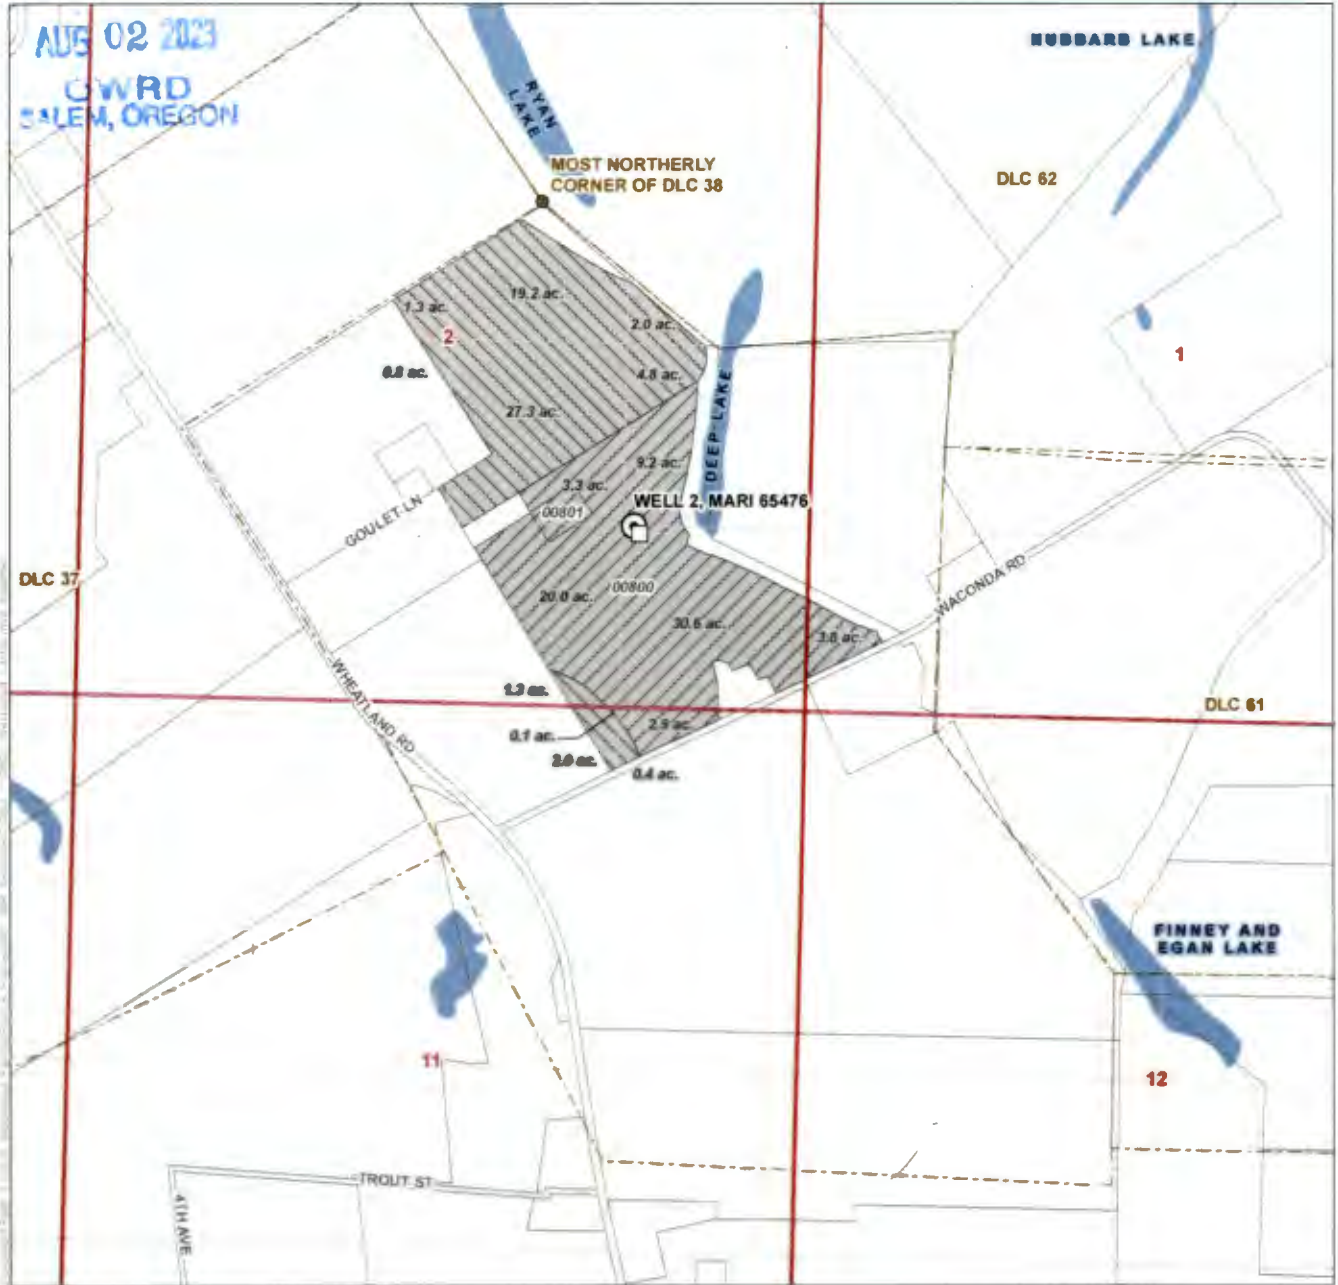


LEGEND

- Point of Appropriation (POA)
- Meter
- Place of Use (POU)**
- Certificate 47856, 59.1 acres
- Certificate 61435, 69.9 acres
- All Other Features**
- Donation Land Claim (DLC)
- Tax Lot
- Watercourse
- Waterbody

Claim of Beneficial Use Map
Westwood Farms, Inc.
T-10602

Township 6 South, Range 3 West (W.M.)

CERTIFIED WATER RIGHTS EXAMINER STAMP

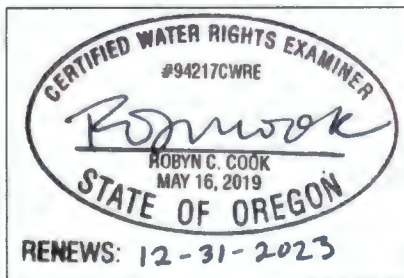

LOCATION DESCRIPTION

Well 2
Located 2310 feet South and 660 feet East from the most Northernly corner of DLC 38, Township 6 South, Range 3 East (W.M.)

DISCLAIMER
This map was prepared for the purpose of identifying the location of a water right only and it is not intended to provide legal dimensions or location of property ownership lines.

Date: April 28, 2023
Data Sources: BLM, ESRI, OWRD, USGS

