


Wheeler County, Oregon
T10S, R20E, W.M.

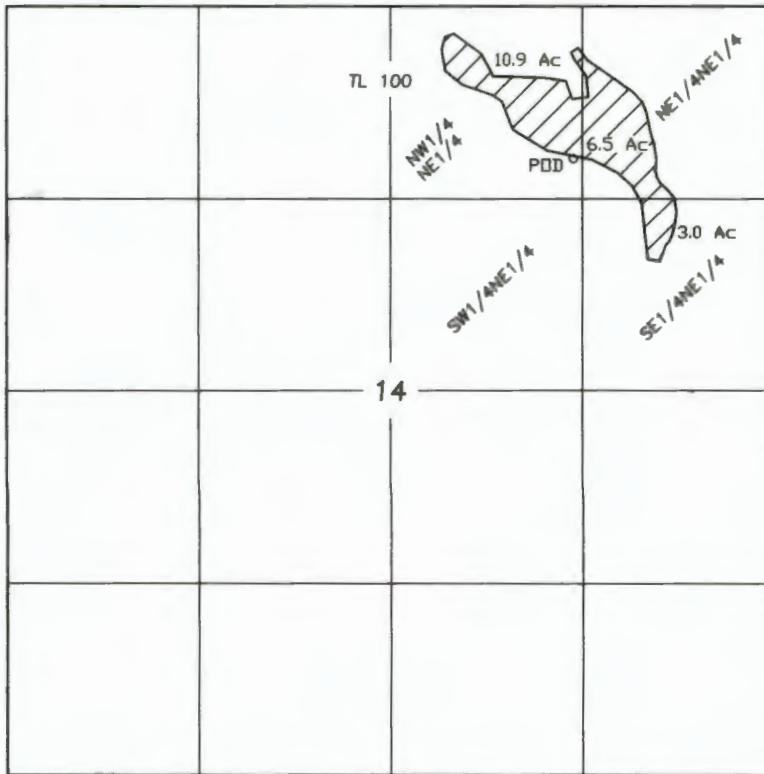

RECEIVED
AUG 07 2023
OWRD


SCALE 1"=1320'

POD is located 1020' South & 1370' East of the
NE corner of Section 14.
Measuring device is located 30' South of the outlet

CLAIM OF BENEFICIAL USE
ADDITIONAL POD
T-9871

June 10, 2022

LEGEND

 T-9871
Priority 1882

A portion of Tax Lot
10-20 TL100

NOTE: Tax Lot 100 is owned by the BLM
and is more that 16,000 acres.
Therefore only a portion of the tax
lot can be shown.

NOTE: The preparation of this map
was for the purpose of identifying
the location of the proposed water
right and has no intent to provide
dimensions or location of property
ownership lines.

For
Bureau of Land Management
28910 Hwy 20 W
Hines, OR 97738

