

CLAIM OF BENEFICIAL USE MAP

TO CHANGE PLACE OF USE AND
POINTS OF APPROPRIATION


FOR T-8375
SAM DINSDALE

TOWNSHIP 26 SOUTH, RANGE 15 EAST, SECTION 32, W.M.
TAX LOT: 5400


RECEIVED

AUG 18 2023


CIVIL
SALEMAN OREGON

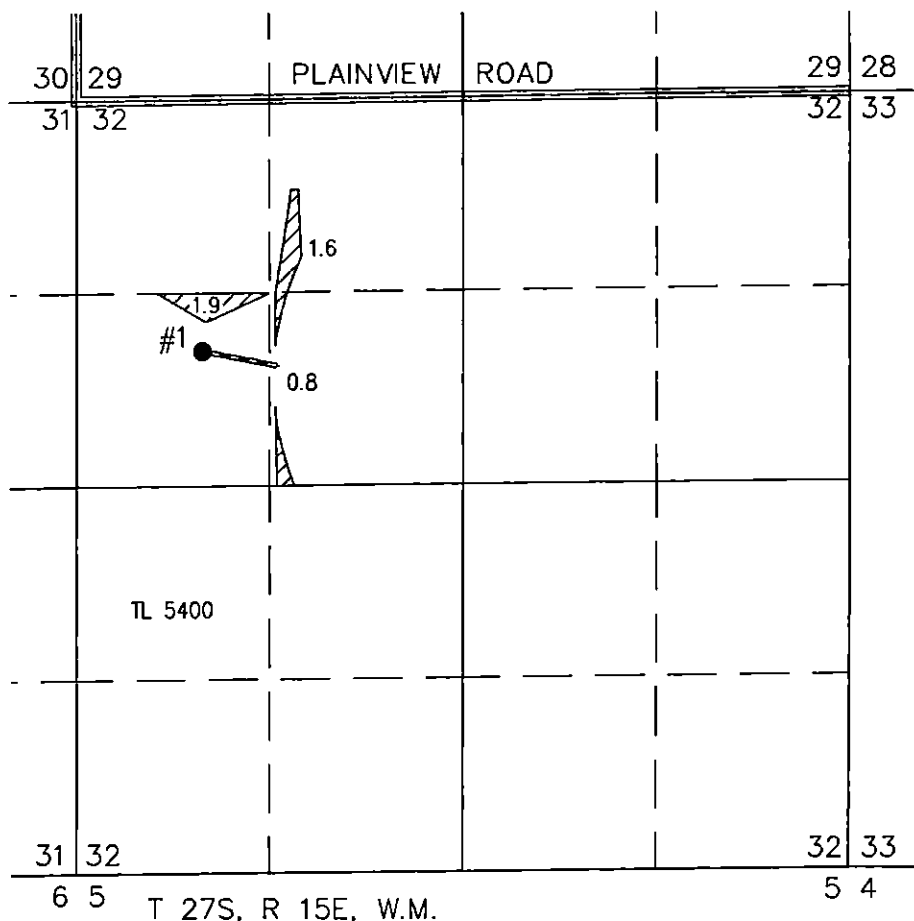

SCALE: 4 INCHES = 1 MILE

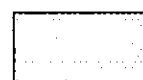

4.3 ACRES WATER RIGHTS
FROM CERTIFICATE #44006
(U-512), AS SHOWN.

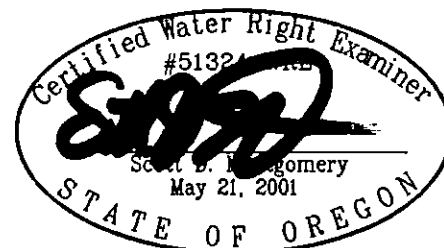

RENEWAL DATE: 12/31/2024

● #1 (LAKE 476)

EXISTING WELL IN THE SW 1/4 NW 1/4 SECTION 32,
T26S R15E, W.M. LOCATED 920 FEET NORTH AND 860
FEET EAST FROM THE W 1/4 CORNER OF SECTION 32.

METER IS LOCATED APPROXIMATELY 10 FEET WEST
ALONG DELIVERY PIPE FROM CENTER PIVOT.

THIS MAP IS FOR THE PURPOSE OF LOCATING A
WATER RIGHT ONLY AND HAS NO INTENT TO
PROVIDE LEGAL DIMENSIONS OR THE LOCATION OF
PROPERTY LINES

PREPARED FOR:

SAM DINSDALE
57673 FORT ROCK ROAD
SILVER LAKE, OR 97638

PREPARED BY:



ALL POINTS ENGINEERING AND SURVEYING, INC.
P.O. BOX 767 TERREBONNE, OR 97760
(541) 548-5833 www.APEandS.com

CLAIM OF BENEFICIAL USE MAP

TO CHANGE PLACE OF USE AND
POINTS OF APPROPRIATION


FOR T-8375
SAM DINSDALE

TOWNSHIP 26 SOUTH, RANGE 15 EAST, SECTION 31, W.M.
TAX LOT: 5200 & 5400

RECEIVED

AUG 18 2023

OWRD
SALEM, OREGON

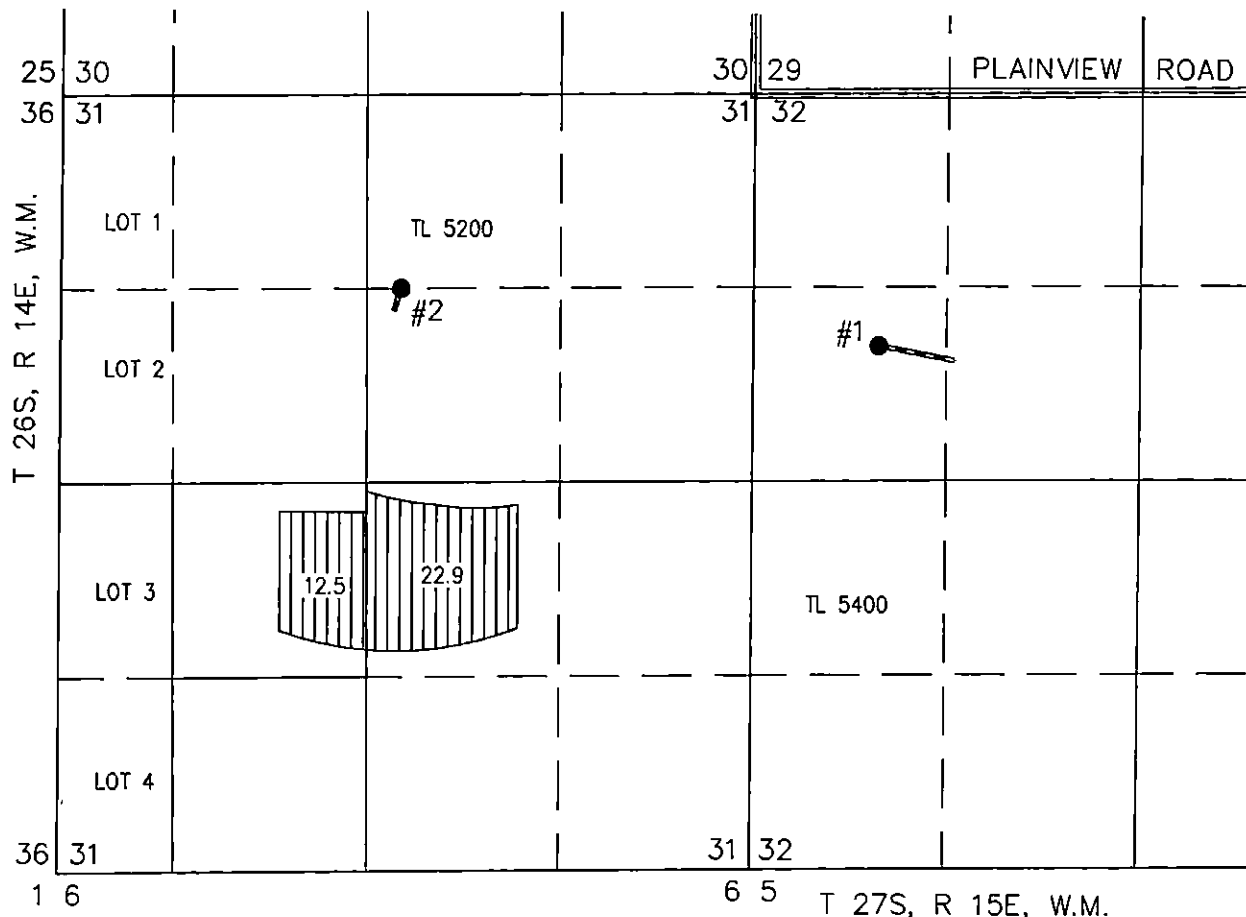


● #2 (LAKE 464)

EXISTING WELL IN THE NW 1/4 NE 1/4 SECTION 31, T26S
R15E, W.M. LOCATED 1320 FEET SOUTH AND 2410 FEET
WEST FROM THE NE CORNER OF SECTION 31.

METER IS LOCATED APPROXIMATELY 6.0 FEET NE
ALONG DELIVERY PIPE FROM CENTER PIVOT.



35.4 ACRES WATER RIGHTS
FROM CERTIFICATE #57125
(G-6406), AS SHOWN.

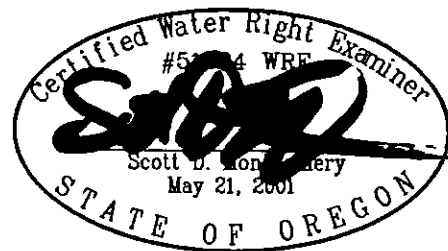

RENEWAL DATE: 12/31/2024

THIS MAP IS FOR THE PURPOSE OF LOCATING A WATER RIGHT ONLY AND HAS NO
INTENT TO PROVIDE LEGAL DIMENSIONS OR THE LOCATION OF PROPERTY LINES

PREPARED FOR:

SAM DINSDALE
57673 FORT ROCK ROAD
SILVER LAKE, OR 97638

PREPARED BY:



ALL POINTS ENGINEERING AND SURVEYING, INC.
P.O. BOX 767
(541) 548-5833
TERREBONNE, OR 97760
www.APEandS.com

CLAIM OF BENEFICIAL USE MAP



TO CHANGE PLACE OF USE AND
POINTS OF APPROPRIATION
FOR T-8375
SAM DINSDALE

TOWNSHIP 26 SOUTH, RANGE 15 EAST, SECTIONS 20 & 29, W.M.
TAX LOT: 2500


RECEIVED

AUG 18 2023

OWRD
SALEM, OREGON

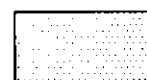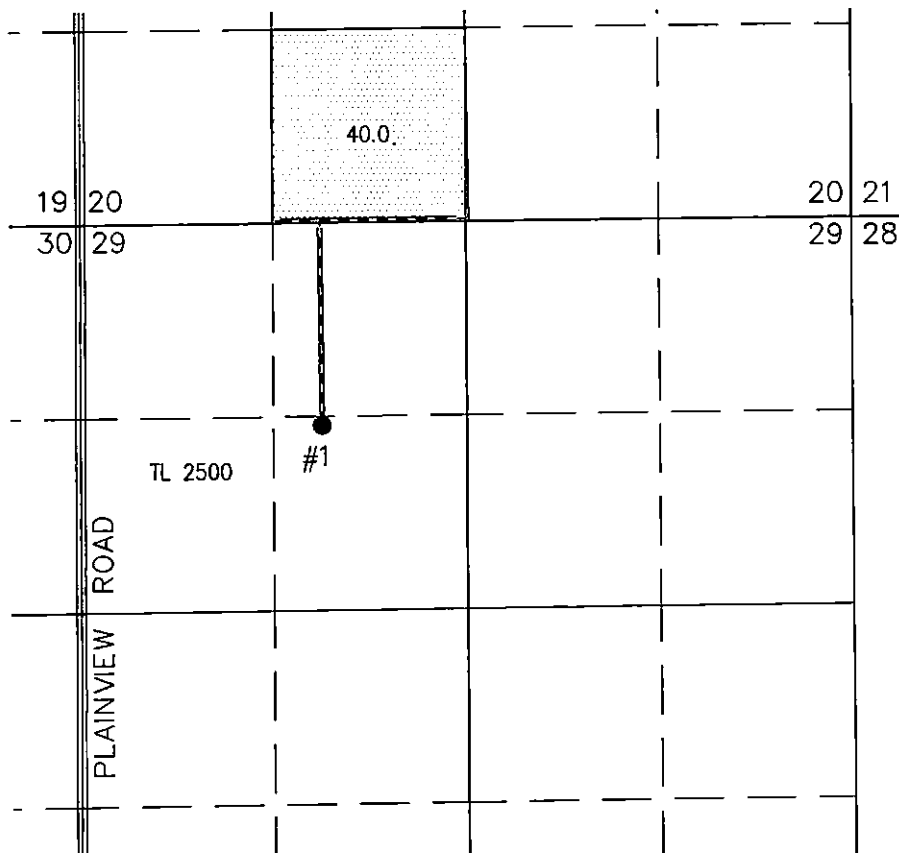

40.0 ACRES WATER RIGHTS
FROM CERTIFICATE #55516
(G-370), AS SHOWN.

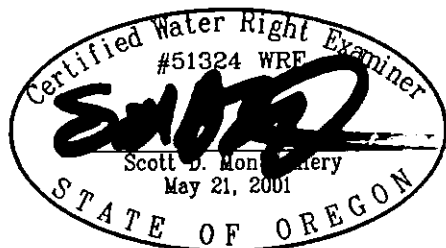

RENEWAL DATE: 12/31/2024

THIS MAP IS FOR THE PURPOSE OF LOCATING A
WATER RIGHT ONLY AND HAS NO INTENT TO
PROVIDE LEGAL DIMENSIONS OR THE LOCATION OF
PROPERTY LINES

● #1 (LAKE 4105)

EXISTING WELL IN THE SE 1/4 NW 1/4 SECTION 29,
T26S R15E, W.M. LOCATED 1380 FEET SOUTH AND 1650
FEET EAST FROM THE NW CORNER OF SECTION 29.

METER IS LOCATED APPROXIMATELY 300 FEET WEST
ALONG DELIVERY PIPE FROM WELL.

PREPARED FOR:

SAM DINSDALE
57673 FORT ROCK ROAD
SILVER LAKE, OR 97638

PREPARED BY:



ALL POINTS ENGINEERING AND SURVEYING, INC.
P.O. BOX 767 TERREBONNE, OR 97760
(541) 548-5833 www.APEandS.com















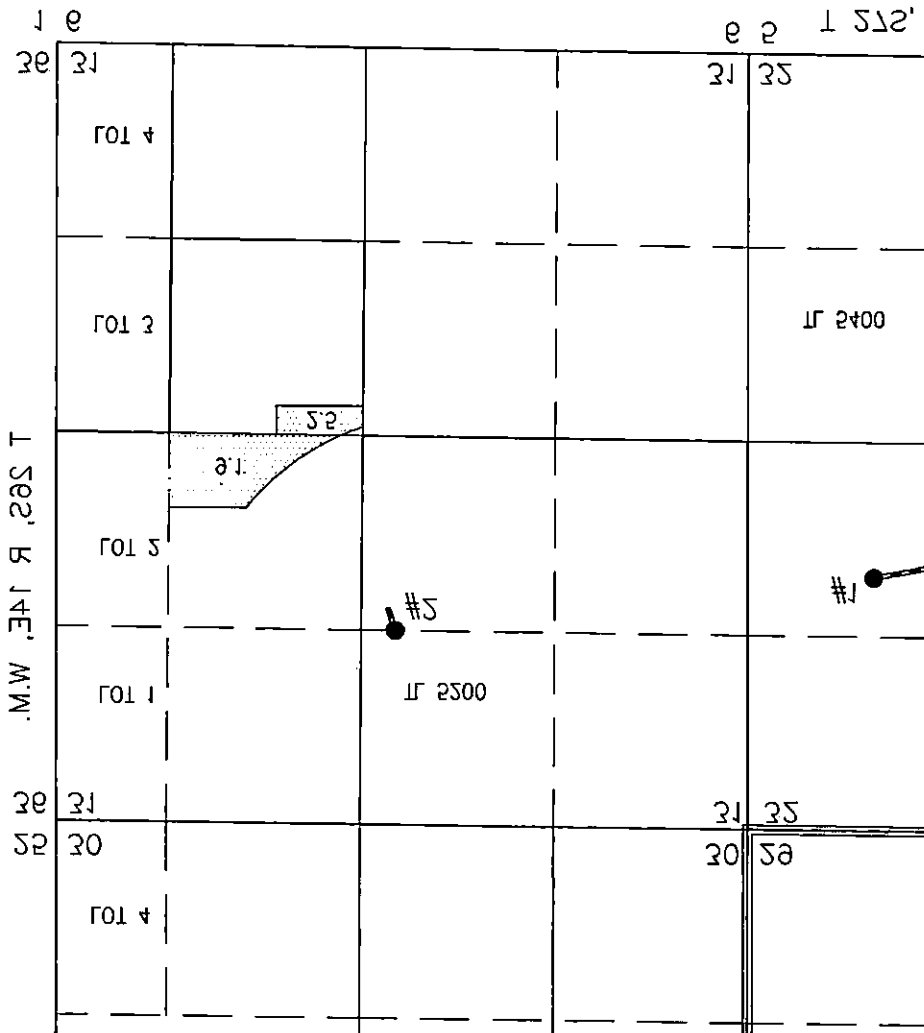













CLAIM OF BENEFICIAL USE MAP

TO CHANGE PLACE OF USE AND
POINTS OF APPROPRIATION


FOR T-8375
SAM DINSDALE

TOWNSHIP 26 SOUTH, RANGE 15 EAST, SECTION 32, W.M.
TAX LOT: 5400

RECEIVED

AUG 18 2020

OWRE
SALEM OFEC

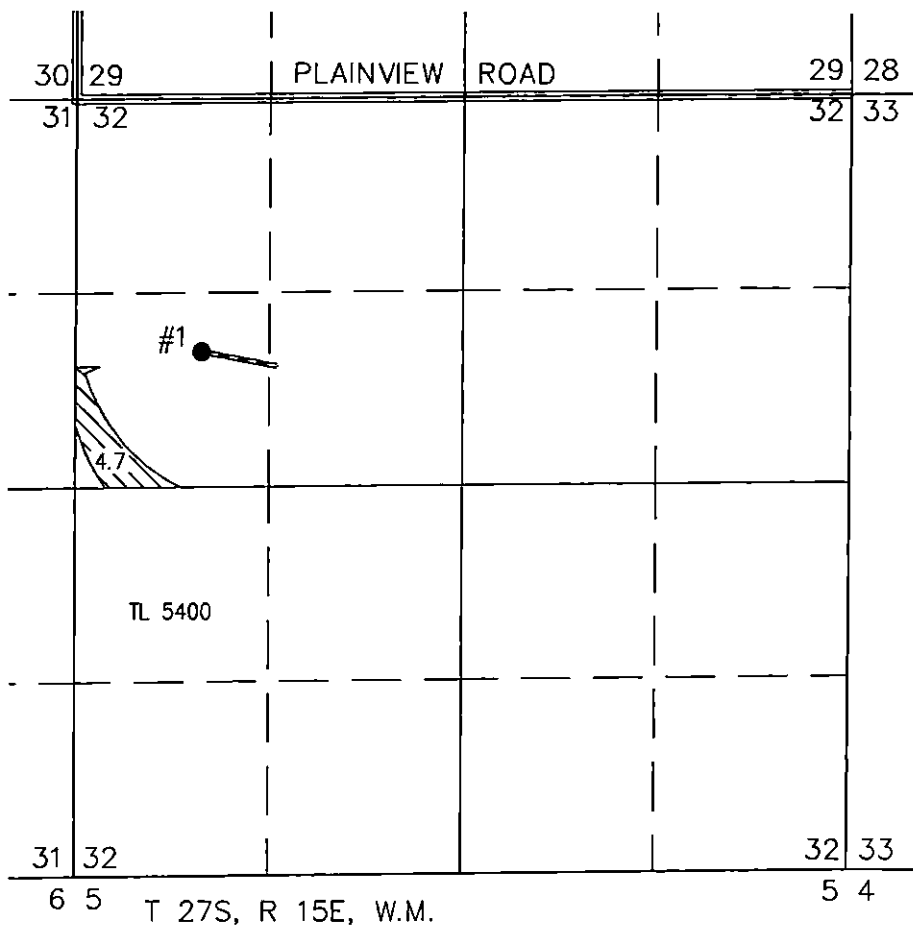

SCALE: 4 INCHES = 1 MILE

4.7 ACRES WATER RIGHTS
FROM CERTIFICATE #27329
(G-1136), AS SHOWN.



RENEWAL DATE: 12/31/2024

● #1 (LAKE 476)

EXISTING WELL IN THE SW 1/4 NW 1/4 SECTION 32,
T26S R15E, W.M. LOCATED 920 FEET NORTH AND 860
FEET EAST FROM THE W 1/4 CORNER OF SECTION 32.

METER IS LOCATED APPROXIMATELY 10 FEET WEST
ALONG DELIVERY PIPE FROM CENTER PIVOT.

THIS MAP IS FOR THE PURPOSE OF LOCATING A
WATER RIGHT ONLY AND HAS NO INTENT TO
PROVIDE LEGAL DIMENSIONS OR THE LOCATION OF
PROPERTY LINES

PREPARED FOR:

SAM DINSDALE
57673 FORT ROCK ROAD
SILVER LAKE, OR 97638

PREPARED BY:



ALL POINTS ENGINEERING AND SURVEYING, INC.
P.O. BOX 767 TERREBONNE, OR 97760
(541) 548-5833 www.APEandS.com














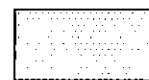





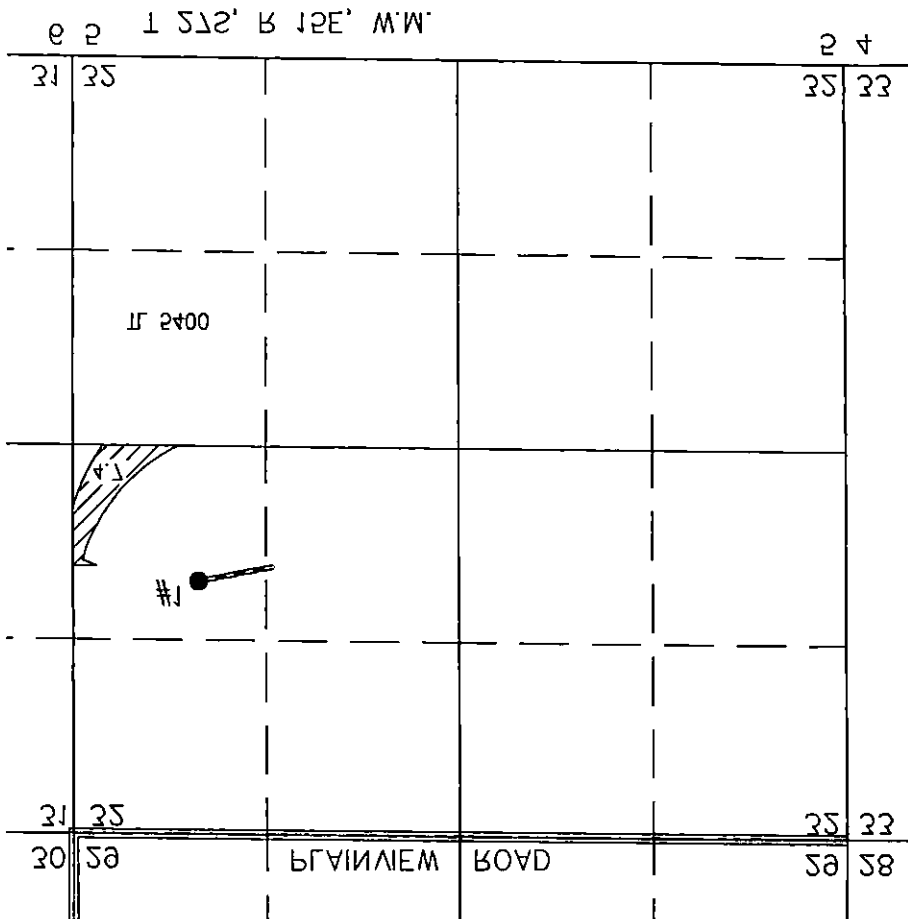











CLAIM OF BENEFICIAL USE MAP


TO CHANGE PLACE OF USE AND
POINTS OF APPROPRIATION
FOR T-8375
SAM DINSDALE

FILED

AUG 18 2023

TOWNSHIP 26 SOUTH, RANGE 15 EAST, SECTION 31, W.M.
TAX LOT: 5200 & 5400

OWAD
CALF M O ECON

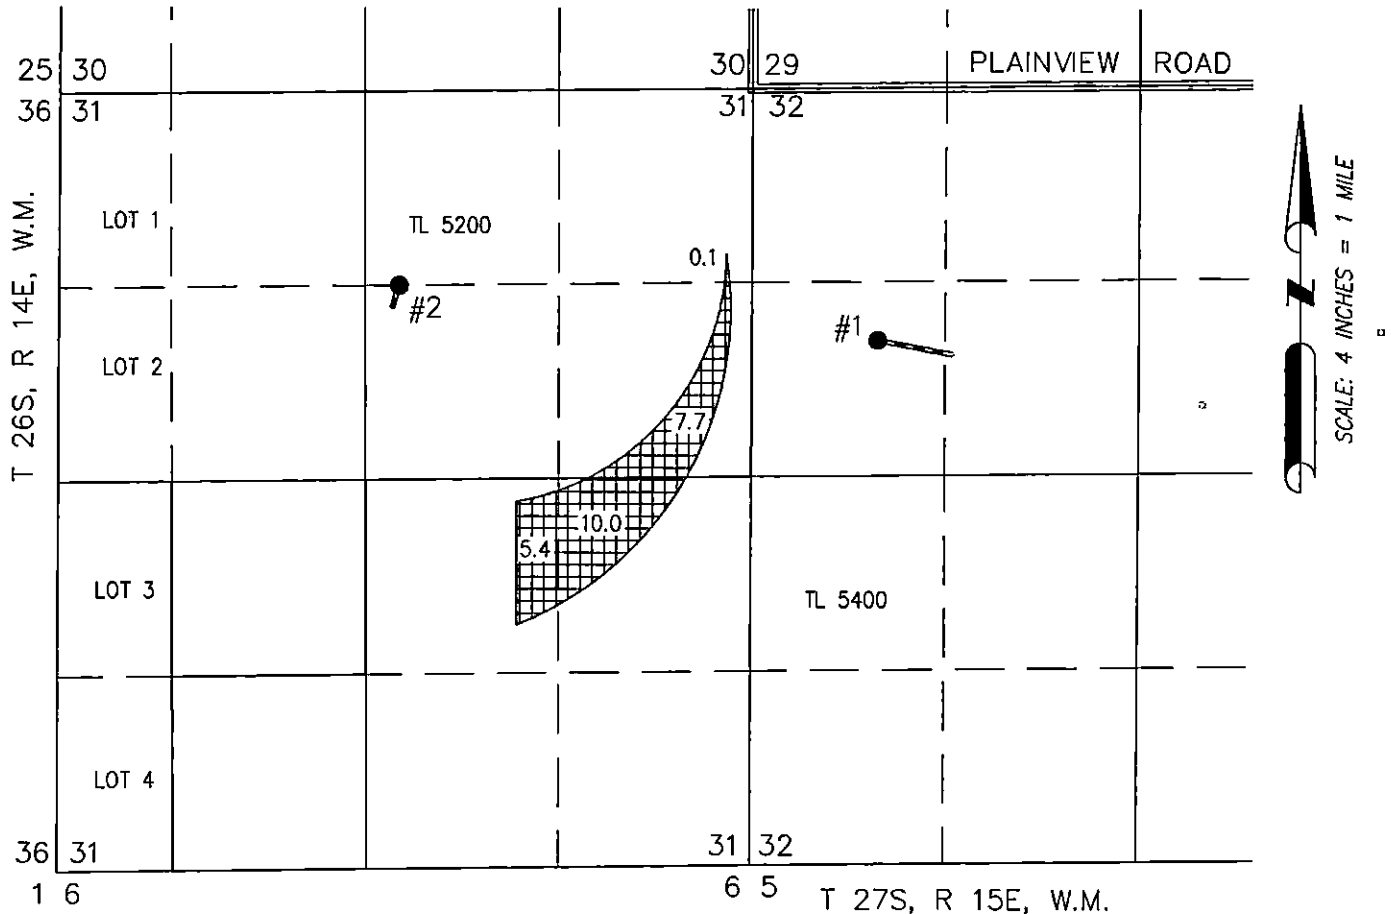


● #2 (LAKE 464)

EXISTING WELL IN THE NW 1/4 NE 1/4 SECTION 31, T26S
R15E, W.M. LOCATED 1320 FEET SOUTH AND 2410 FEET
WEST FROM THE NE CORNER OF SECTION 31.

METER IS LOCATED APPROXIMATELY 6.0 FEET NE
ALONG DELIVERY PIPE FROM CENTER PIVOT.



23.2 ACRES WATER RIGHTS
FROM CERTIFICATE #83561
(G-9471), AS SHOWN.

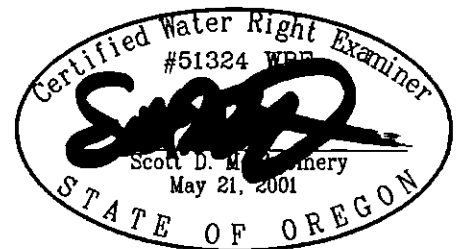

RENEWAL DATE: 12/31/2024

THIS MAP IS FOR THE PURPOSE OF LOCATING A WATER RIGHT ONLY AND HAS NO
INTENT TO PROVIDE LEGAL DIMENSIONS OR THE LOCATION OF PROPERTY LINES

PREPARED FOR:

SAM DINSDALE
57673 FORT ROCK ROAD
SILVER LAKE, OR 97638

PREPARED BY:



ALL POINTS ENGINEERING AND SURVEYING, INC.
P.O. BOX 767
(541) 548-5833
TERREBONNE, OR 97760
www.APEandS.com