

DEC 2 1984

Barbara J. Hilkey
Charles M. Hilkey
776 Holcomb Sp. Rd
Gold Hill, OR
97525

Divine Mothers Farm:

Res.

House


Carroll Creek

Pump House

Middle Creek

Sons Creek

Holcomb Sp Rd.

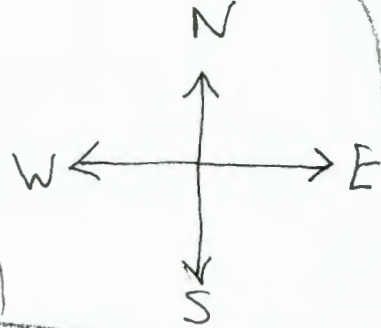

Legal Description: Township 35-S, Range 3-W
Section 25, Tax lot 2200