



CLAIM OF BENEFICIAL USE MAP  
TRANSFER T-12791  
SECTION 12, TOWNSHIP 35 SOUTH, RANGE 2 WEST W.M.  
JACKSON COUNTY, OREGON

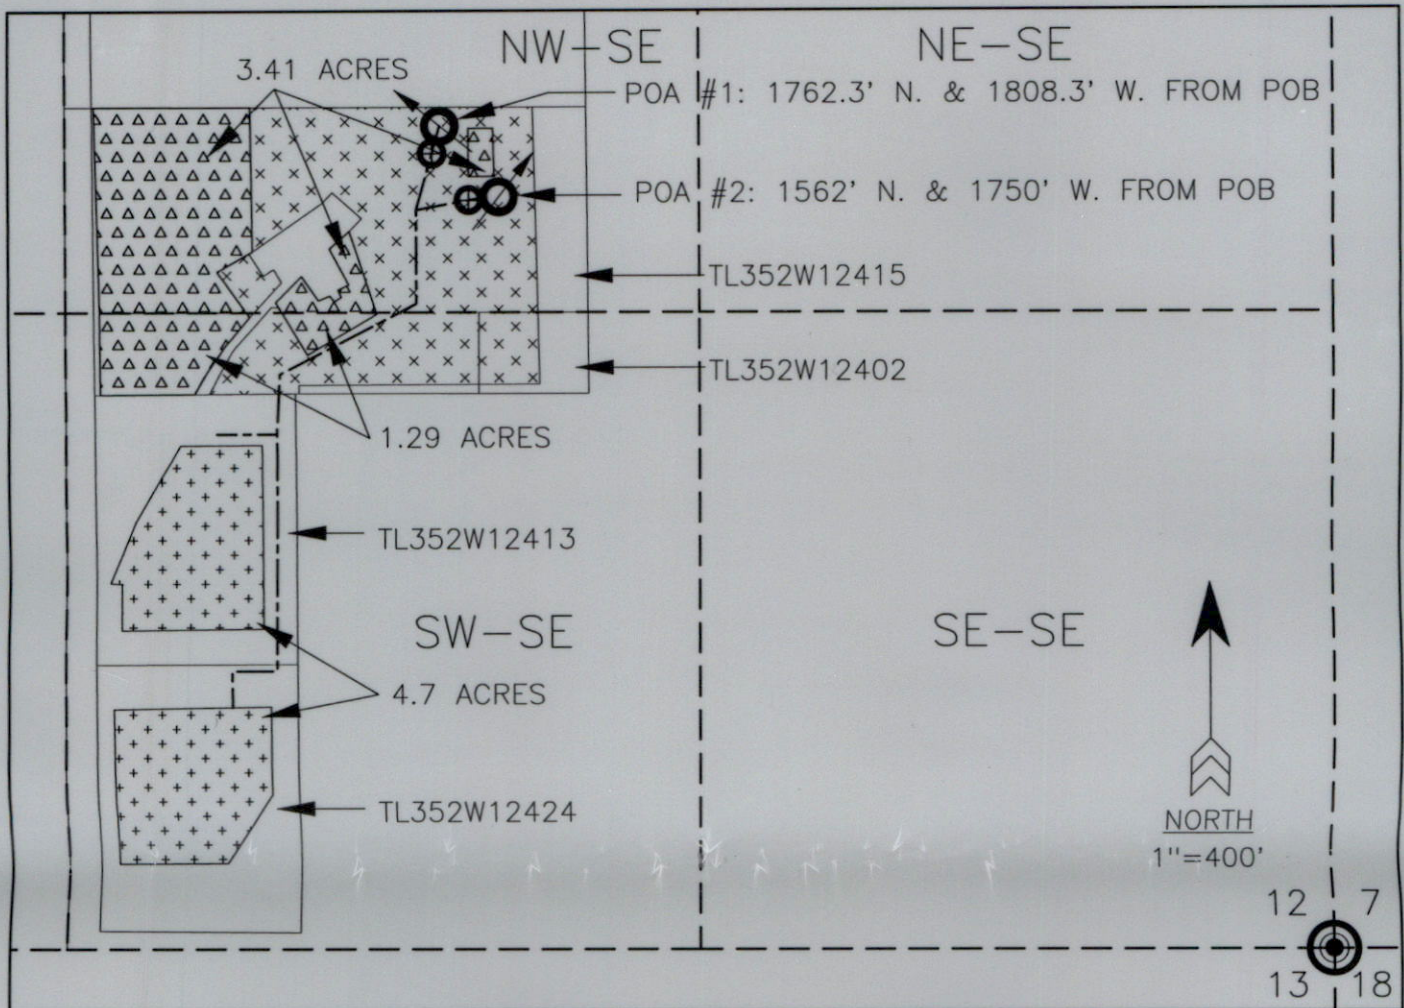

LEGEND

(SYMBOLS NOT TO SCALE)

- PLACE OF USE:  
-AUTHORIZED UNCHANGED
- TRANSFER FROM
- TRANSFER TO
- MAINLINE
- TAXLOT BOUNDRIES
- 1/16TH SECTION LINES
- POINT OF BEGINNING (POB):  
-SE COR. SEC. 12, T.35S., R.2W., W.M.
- POINT OF APPROPRIATION (POA):  
-POA #1
- POA #2
- TOTALIZING FLOW METER

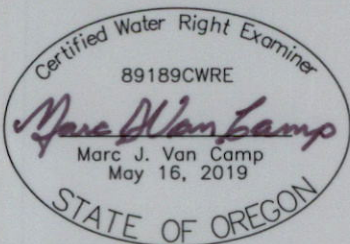

EXPIRES 06/30/2024

DISCLAIMER: THIS MAP WAS PREPARED FOR THE PURPOSE OF IDENTIFYING THE LOCATION OF WATER RIGHT ONLY AND IS NOT INTENDED TO PROVIDE LEGAL DESCRIPTIONS OR LOCATIONS OF PROPERTY LINES.



P.O. Box 995  
Coos Bay, OR 97420  
(541) 297-1880  
vancampconsulting@gmail.com

Prepared For:  
Coby & Marcie Roberts  
1107 Coggins Street  
Redding, CA 96003

Project:  
T-12791  
Claim of Beneficial Use

Date:  
July 14, 2023