


8

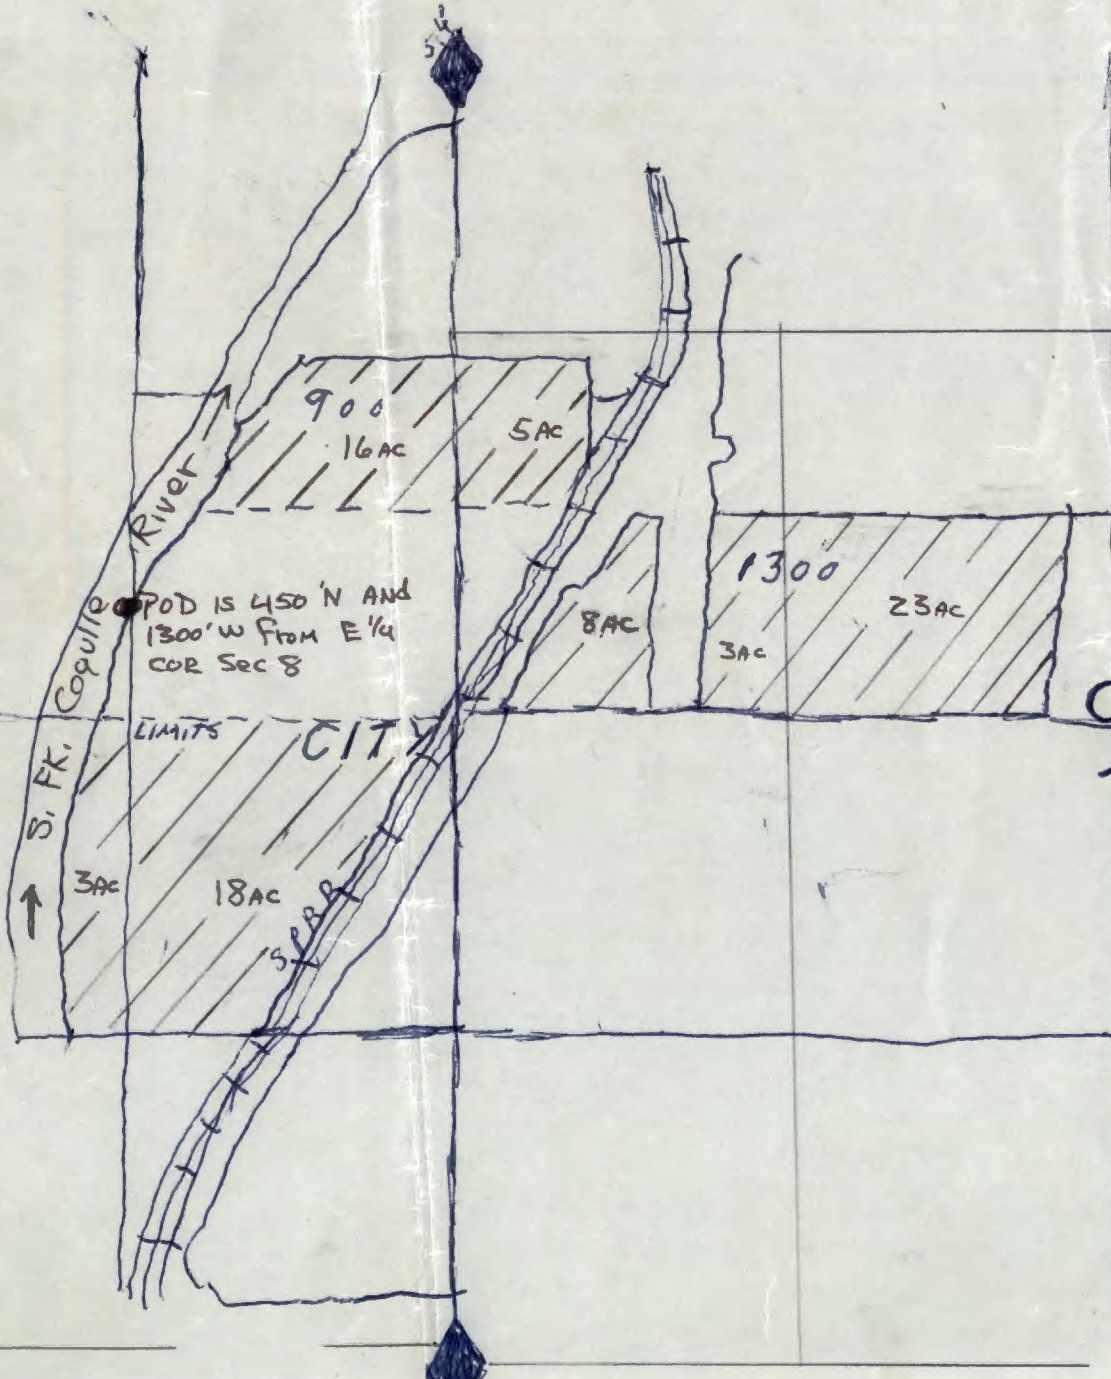

RECEIVED

APR 17 1986

WATER RESOURCES DEPT
SALEM, OREGON

TZ9S R12W

RECEIVED

MAY 29 1986

WATER RESOURCES DEPT
SALEM, OREGON

W + E
Scale
1" = 800'

Map drew by John Dales
State of Oregon Water
Resources Department

Application No. 68707

Permit No.

49668