

LOCATED IN
SECTION 28; T5N R2W W.M.
COLUMBIA COUNTY, OREGON
CLAIM OF BENEFICIAL USE MAP

TAX LOT 100
TAX MAP 5022800
APPLICATION R-63272
PERMIT R-11387



CWRE STATEMENT
THIS MAP IS NOT INTENDED TO PROVIDE LEGAL DIMENSIONS OF
LOCATIONS OF PROPERTY OWNERSHIP LINES.

MAP INFORMATION
COORDINATE SYSTEM: STATE PLANE OREGON NORTH ZONE 3601
DATUM: NORTH AMERICAN DATUM OF 1983

DATA SOURCES
TAX LOT AND ROAD: COLUMBIA COUNTY GIS
SECTION LINEWORK: COLUMBIA COUNTY GIS

PREPARED FOR
CITY OF ST. HELENS
265 STRAND STREET, OR 97051

RECEIVED
AUG 30 2023
OWRD

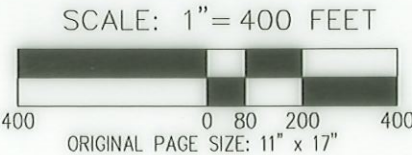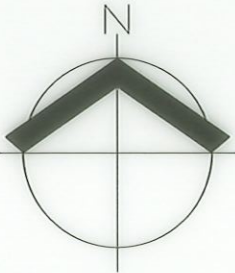

DATE: 08/17/2023

CLAIM OF BENEFICIAL USE MAP

SALMONBERRY RESERVOIR WATER RIGHTS


AKS ENGINEERING & FORESTRY, LLC
12965 SW HERMAN RD, STE 100
TUALATIN, OR 97062
503.563.6151 WWW.AKS-ENG.COM



EXHIBIT

A

DRWN: BGZ
CHKD: SRR
AKS JOB:
9935

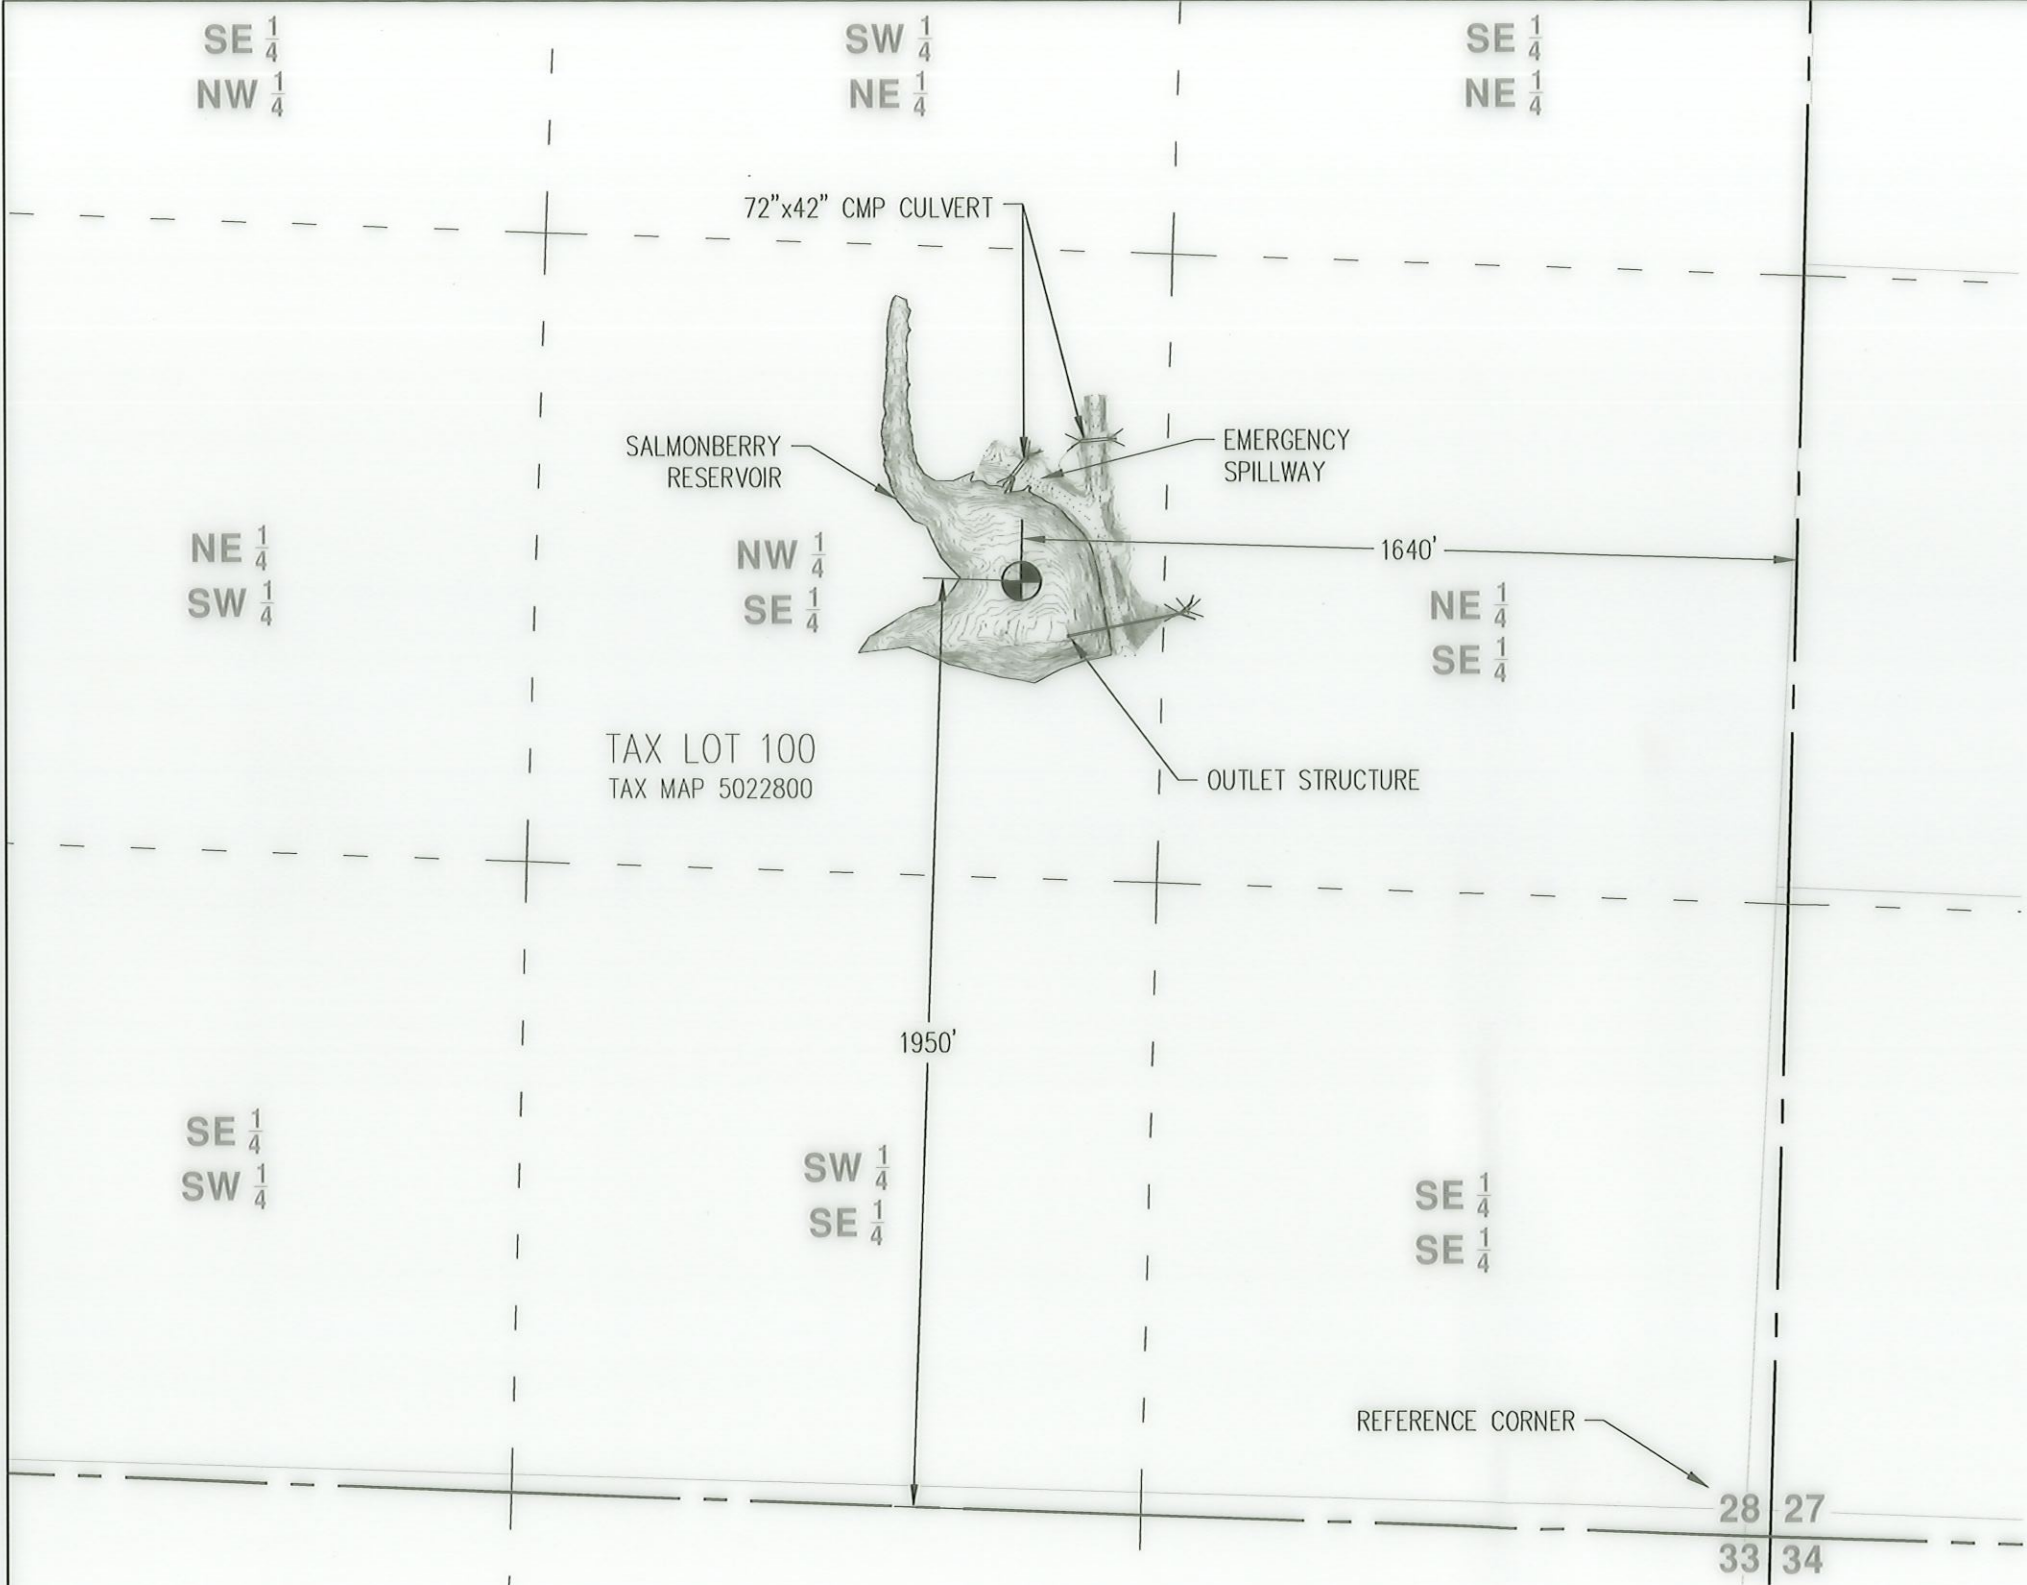

LEGEND

- POINT OF APPROPRIATION (POA)
- TAX LOT BOUNDARY
- 1/4 1/4 SECTION LINE
- SECTION LINE

SALMONBERRY RESERVOIR
59.7 ACRE-FEET

