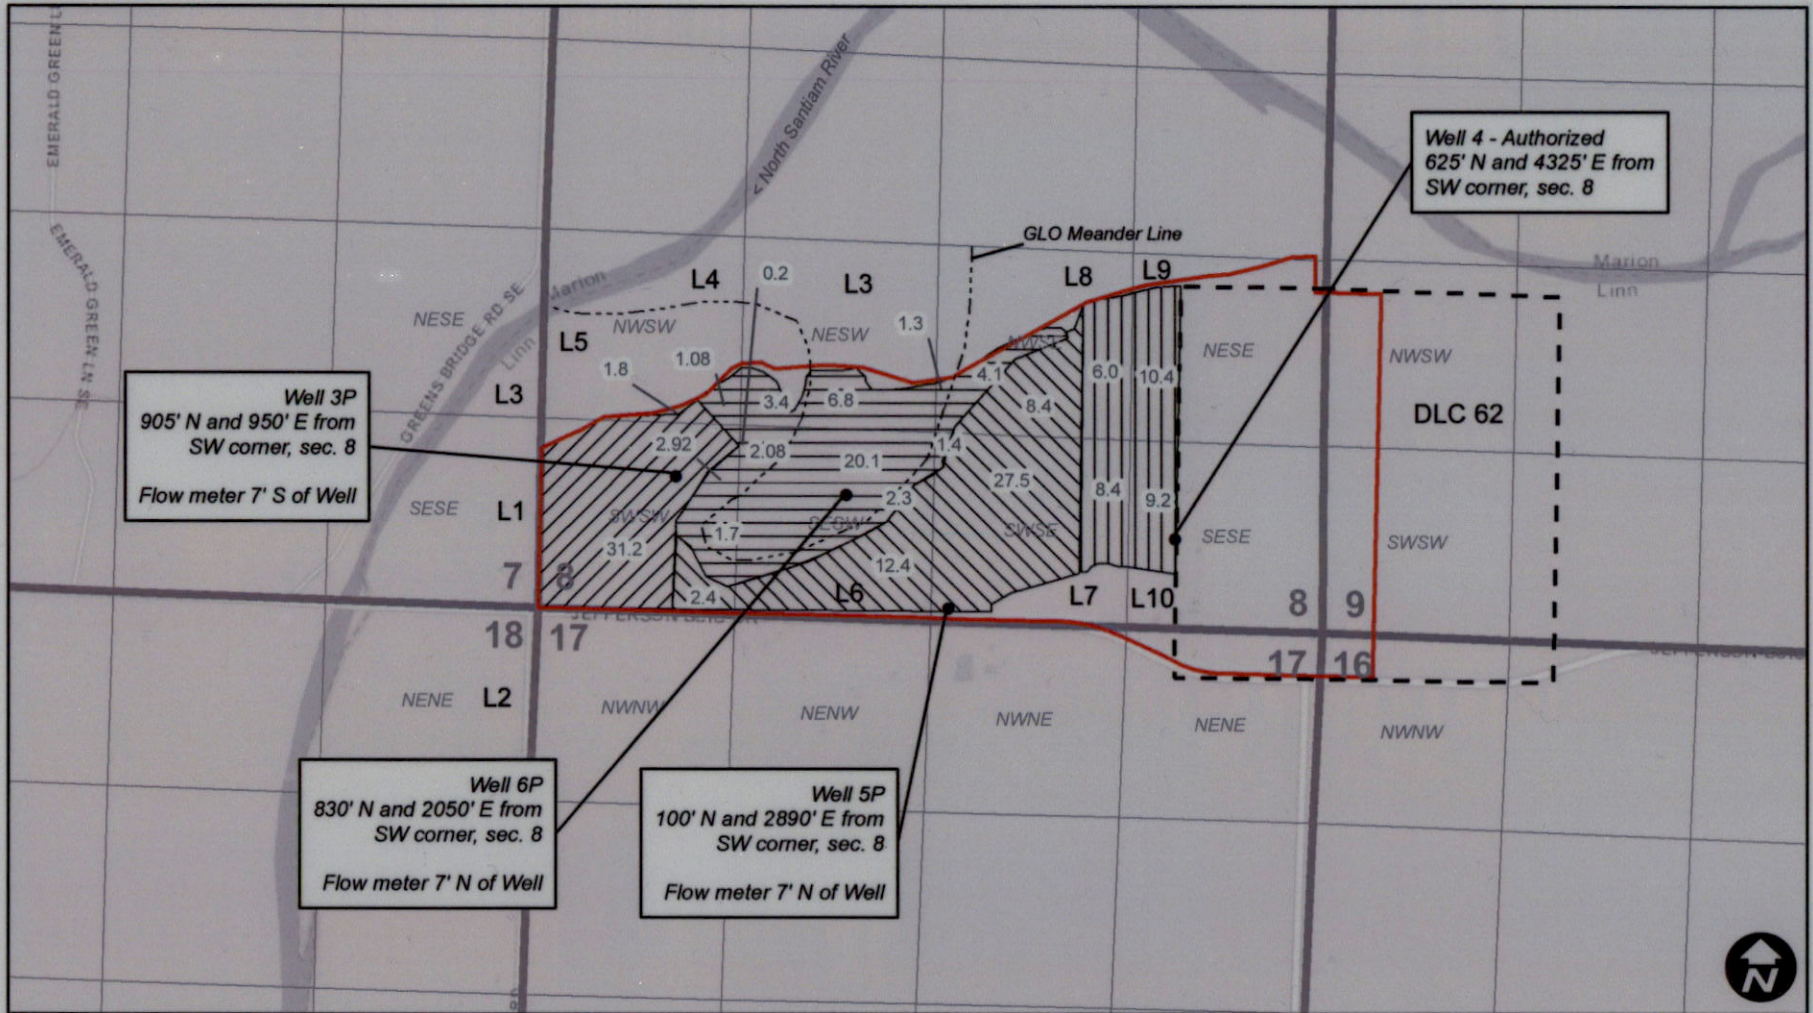


Meduri Farms - Claim of Beneficial Use Transfer T-11316



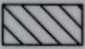
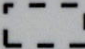
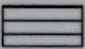
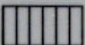
Township 10S, Range 2W, W.M.



This map is not intended to provide legal dimensions or locations of property ownership lines.

0 660 1,320 2,640 Feet

Legend

-  T-11316 (Well 3P)  Taxlot 100
-  T-11316 (Well 5P)  DLC
-  T-11316 (Well 6P)
-  T-11316 (Well 4) Pending Reversion for APOA, Well 8



EXPIRES: 12-31-2024

RECEIVED
SEP 05 2023
OWRD