


# AVION WATER C

# APPLICATION MAP FOR A PERM

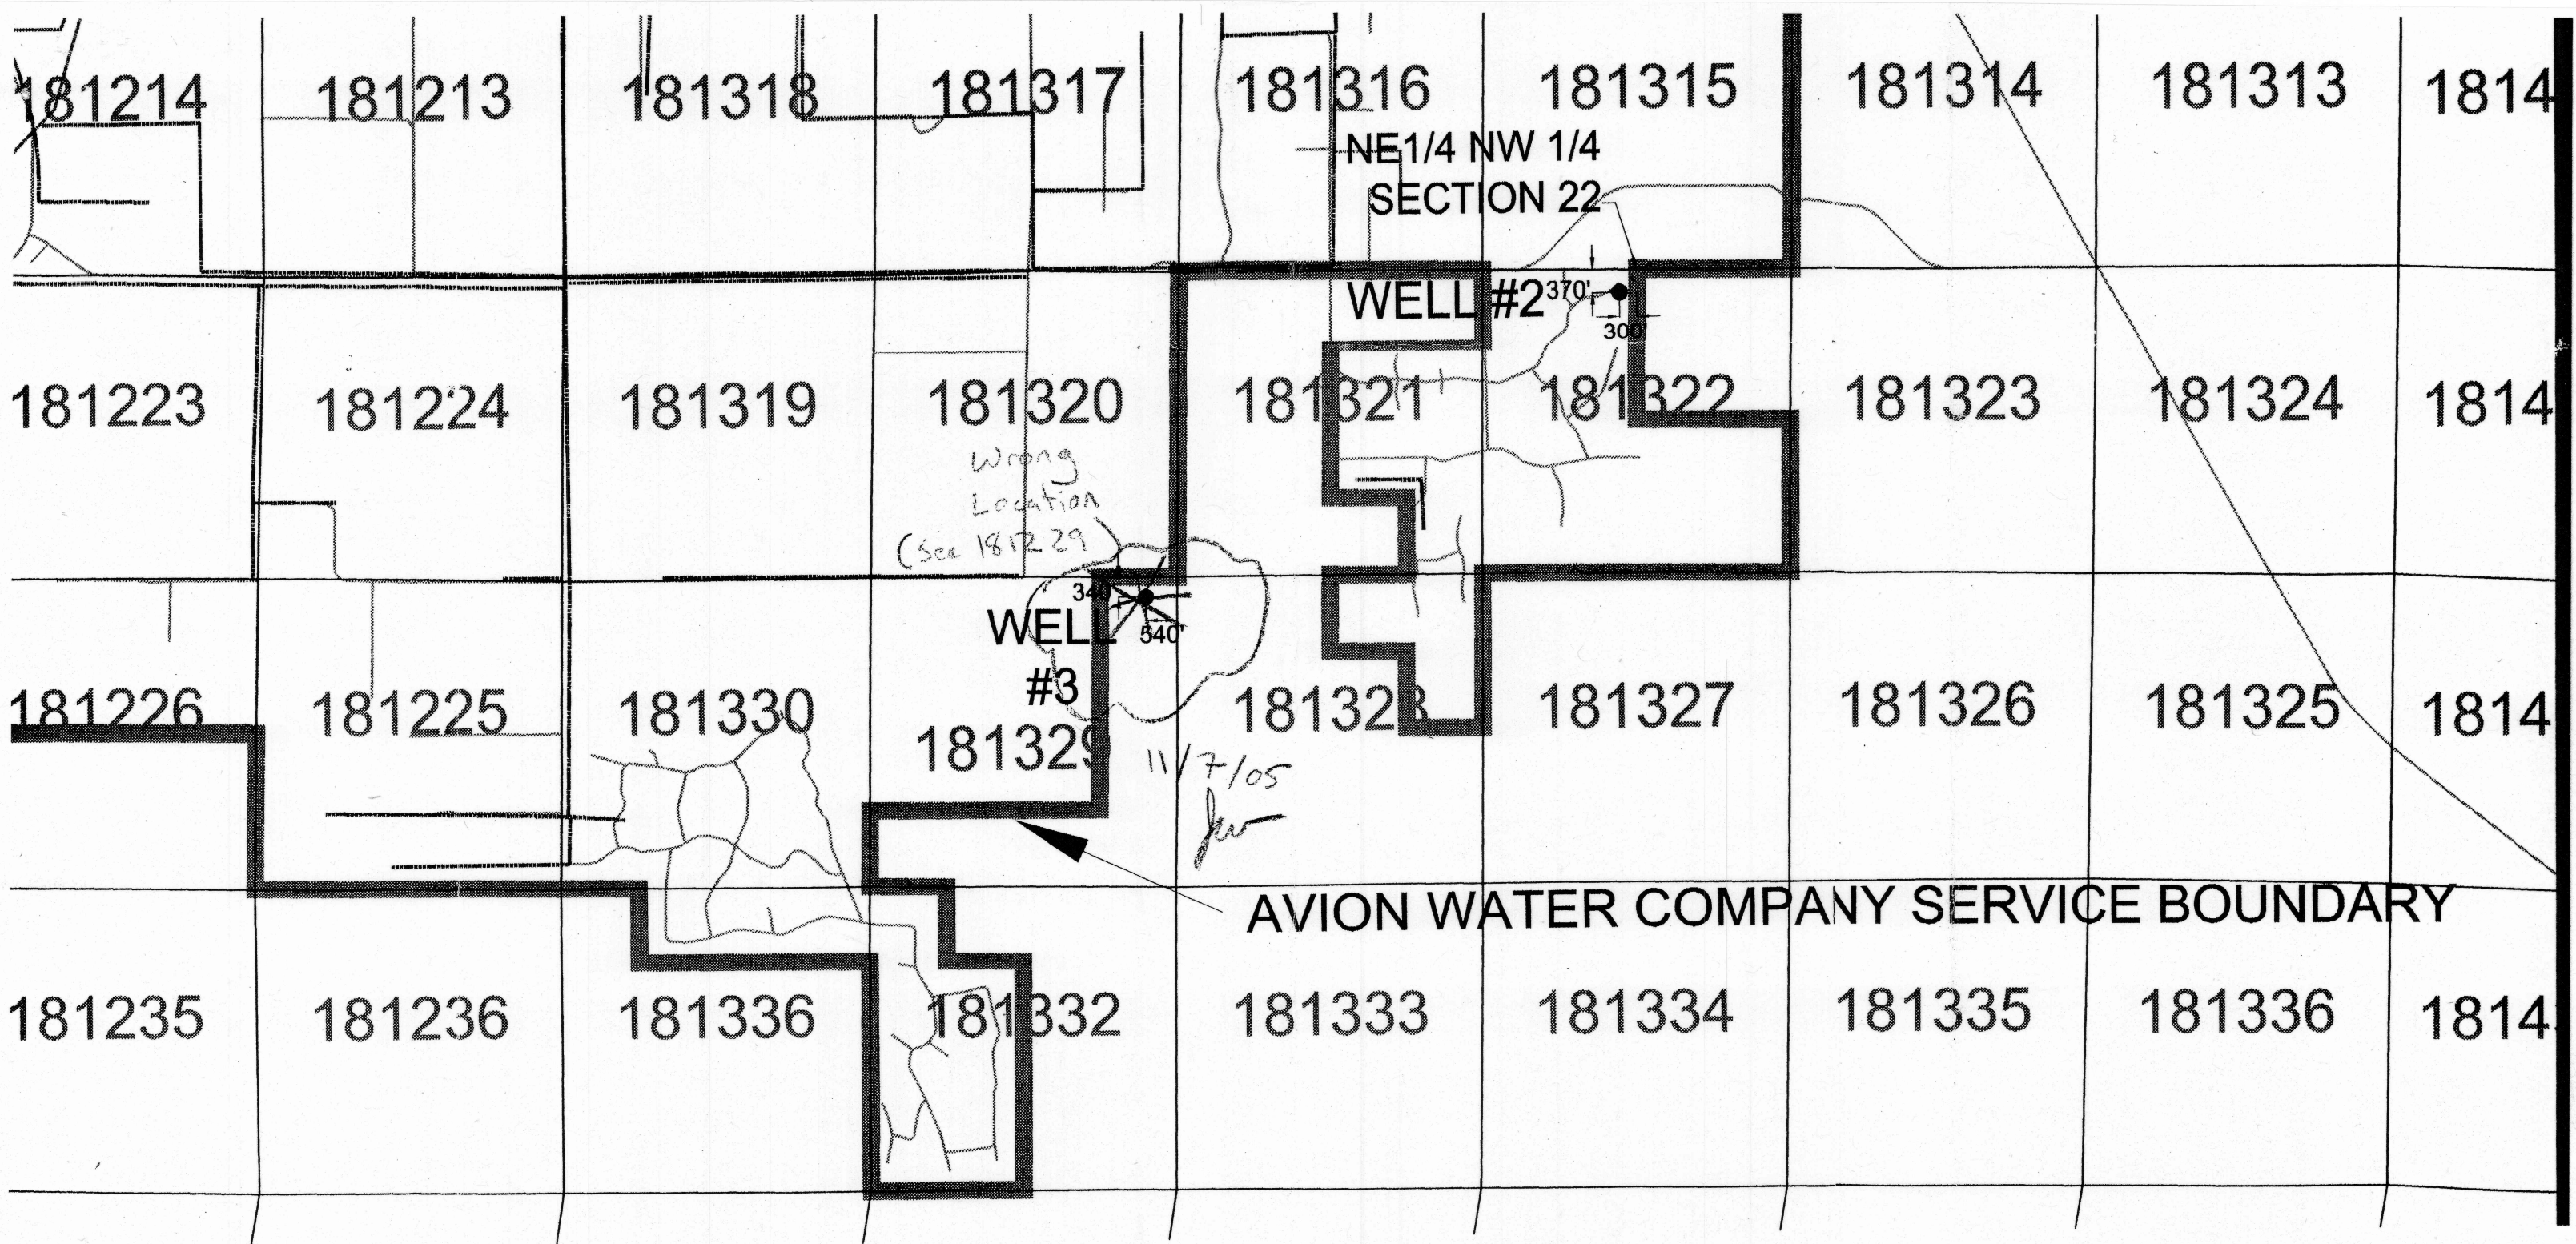






**TER COMPANY, INC**

**A PERMIT TO USE GROUNDWATER**






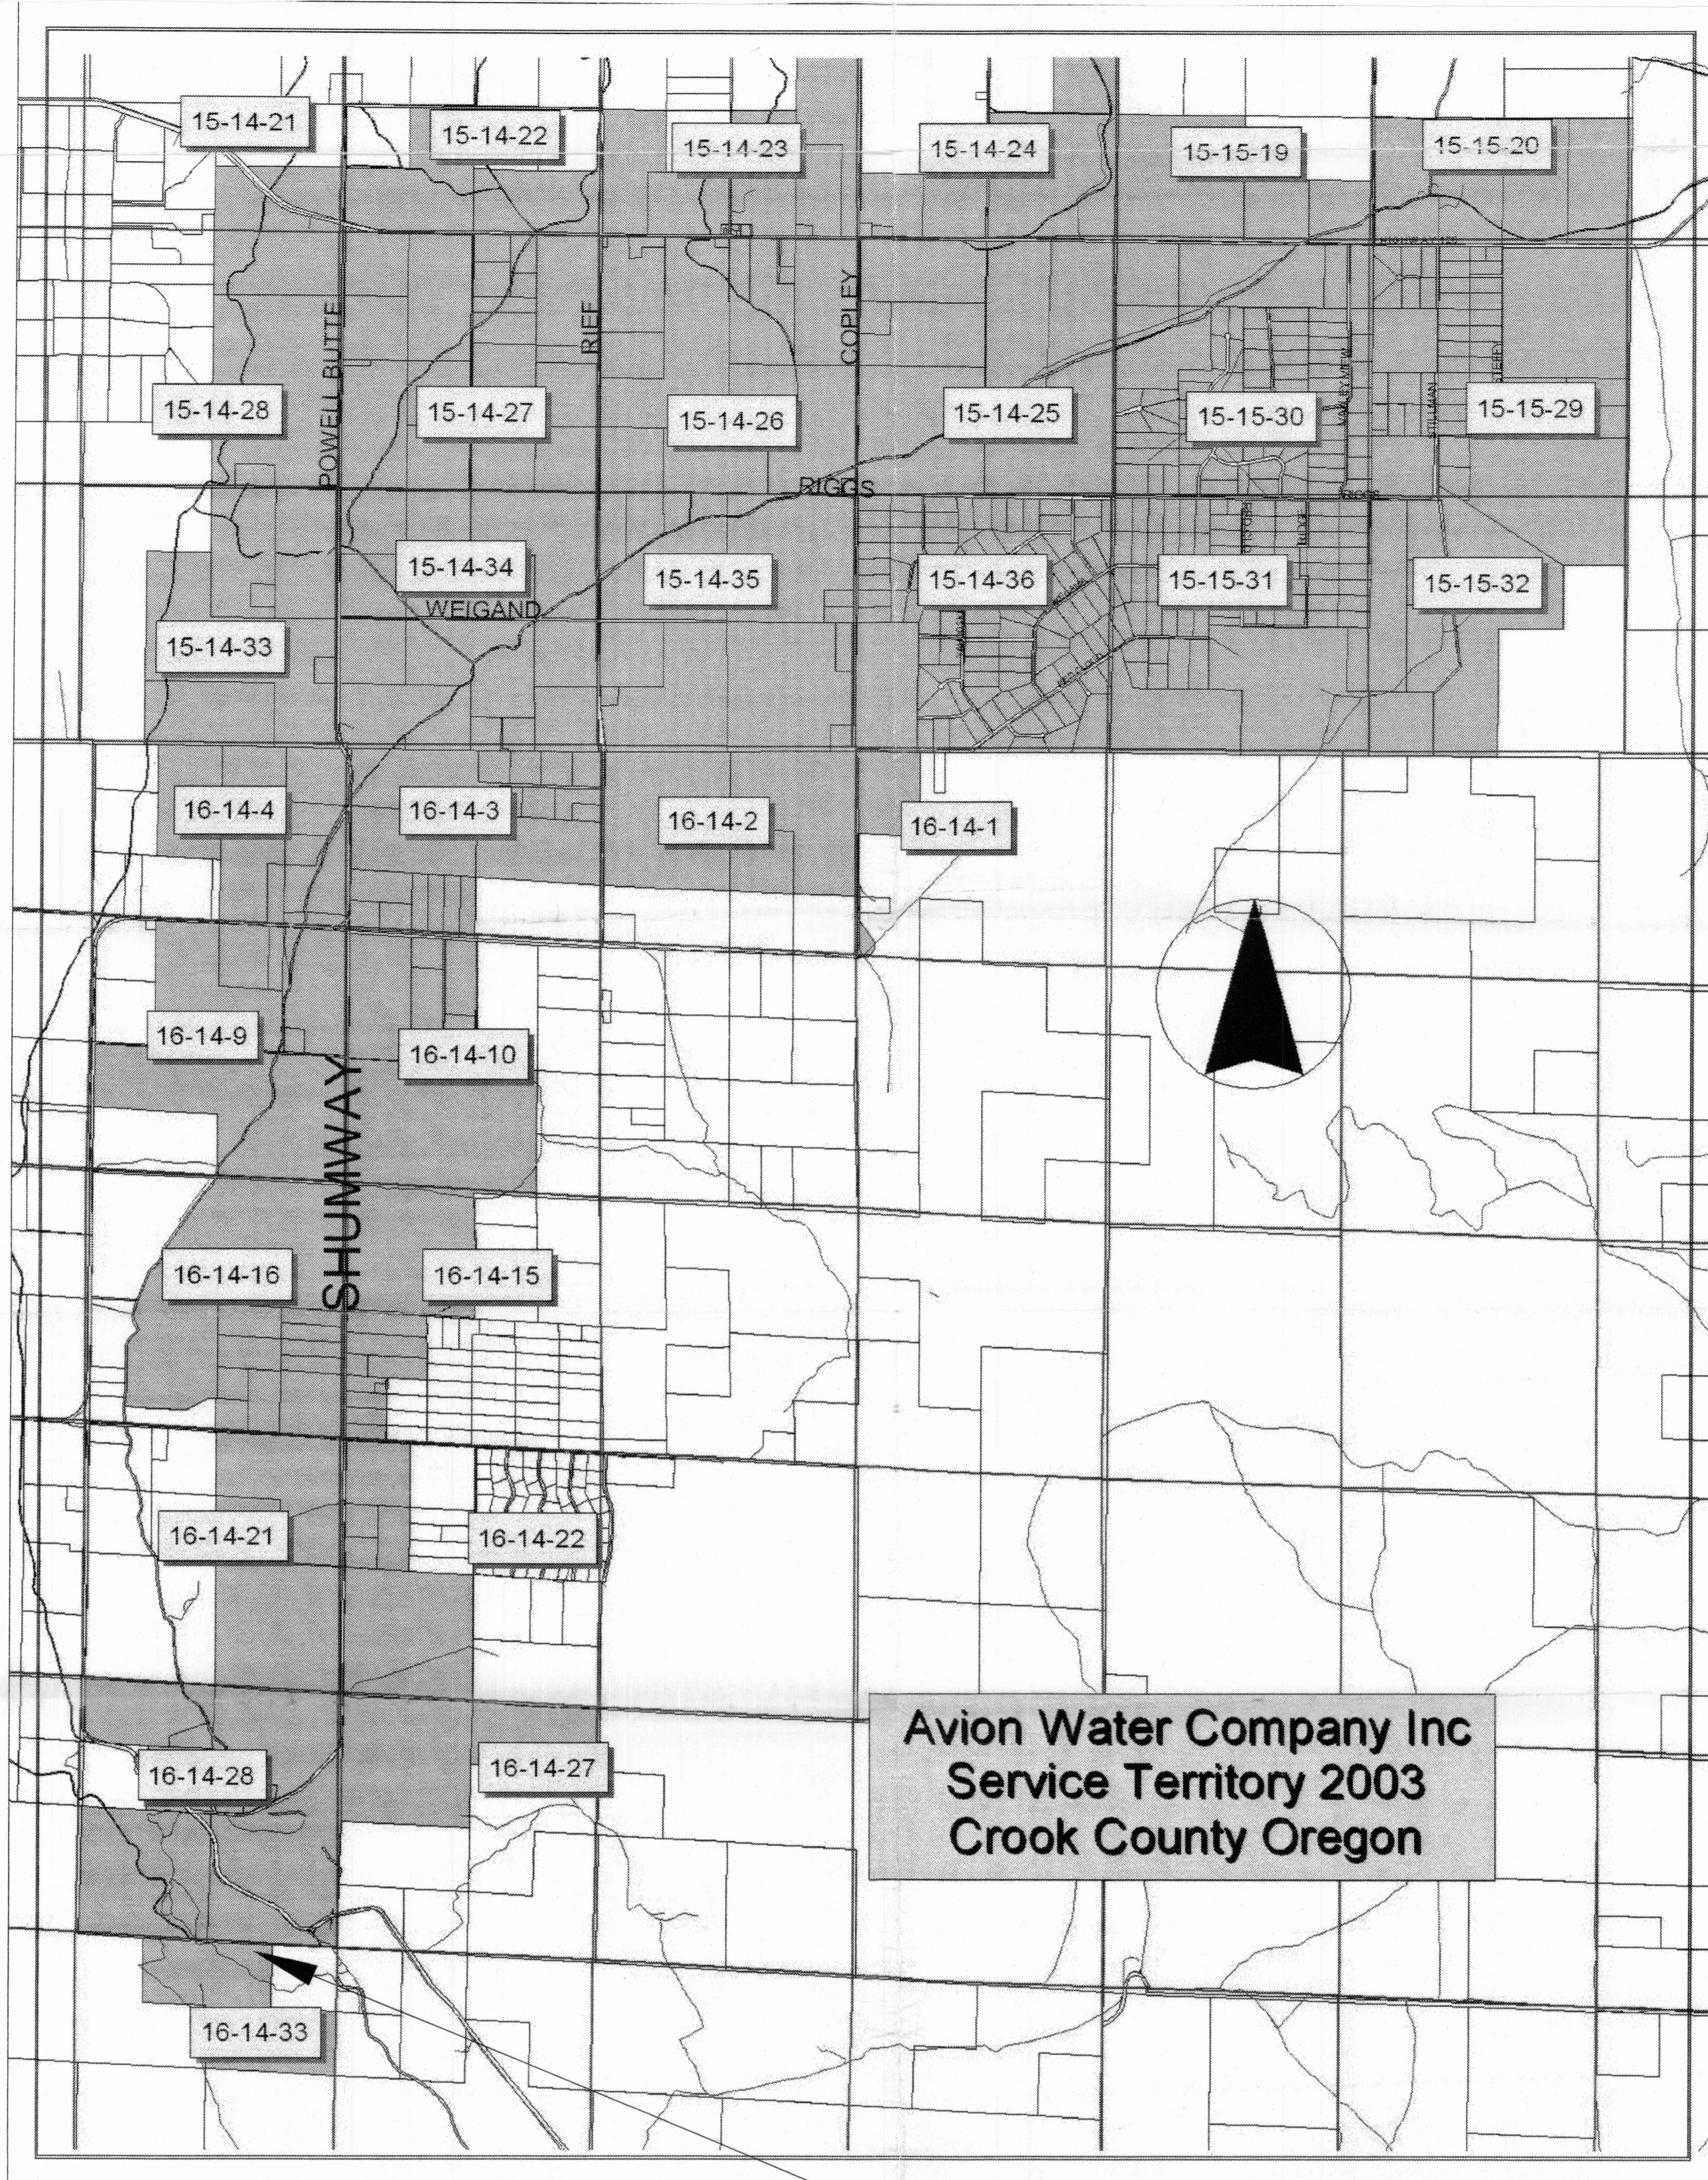

**Avion Water Company Inc  
Service Territory 2003  
Crook County Oregon**

AVION WATER COMPANY BOUNDARY

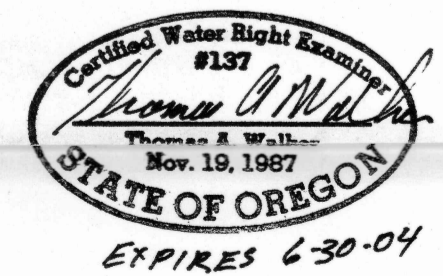

# AVION WATER COMPANY, INC APPLICATION MAP FOR A PERMIT TO USE GROUNDWATER



920 Emkay, Suite C-100  
Bend, Oregon  
97702-1041

(541)388-4255  
(541)388-4229 Fax  
whpacific.com

**SHEET 3 OF 3**

RECEIVED  
JUL 28 2003  
WATER RESOURCES DEPT  
SALEM, OREGON

*approx 6/16/03*

NOTE: THIS MAP WAS PREPARED FOR THE PURPOSE OF IDENTIFYING THE LOCATION OF WATER RIGHTS. THIS MAP IS NOT INTENDED TO PROVIDE DIMENSIONS OR THE LOCATION OF PROPERTY OWNERSHIP LINES.

NOTE: THIS DRAWING WAS ORIGINALLY PREPARED AND PROVIDED BY AVION WATER COMPANY, INC AND SUBSEQUENTLY MODIFIED BY W&H PACIFIC.

