


CLAIM of BENEFICIAL USE

FOR RICK & GAIL WEAVER
 BY NATHAN REED PE CWRE
 T29S, R5W, W.M. SECTION 32, DLC 43
 APPLICATION NO.: S-89192
 PERMIT NO.: S-55380

SCALE: 1" = 400'

DATE OF SURVEY: AUGUST 11, 2023

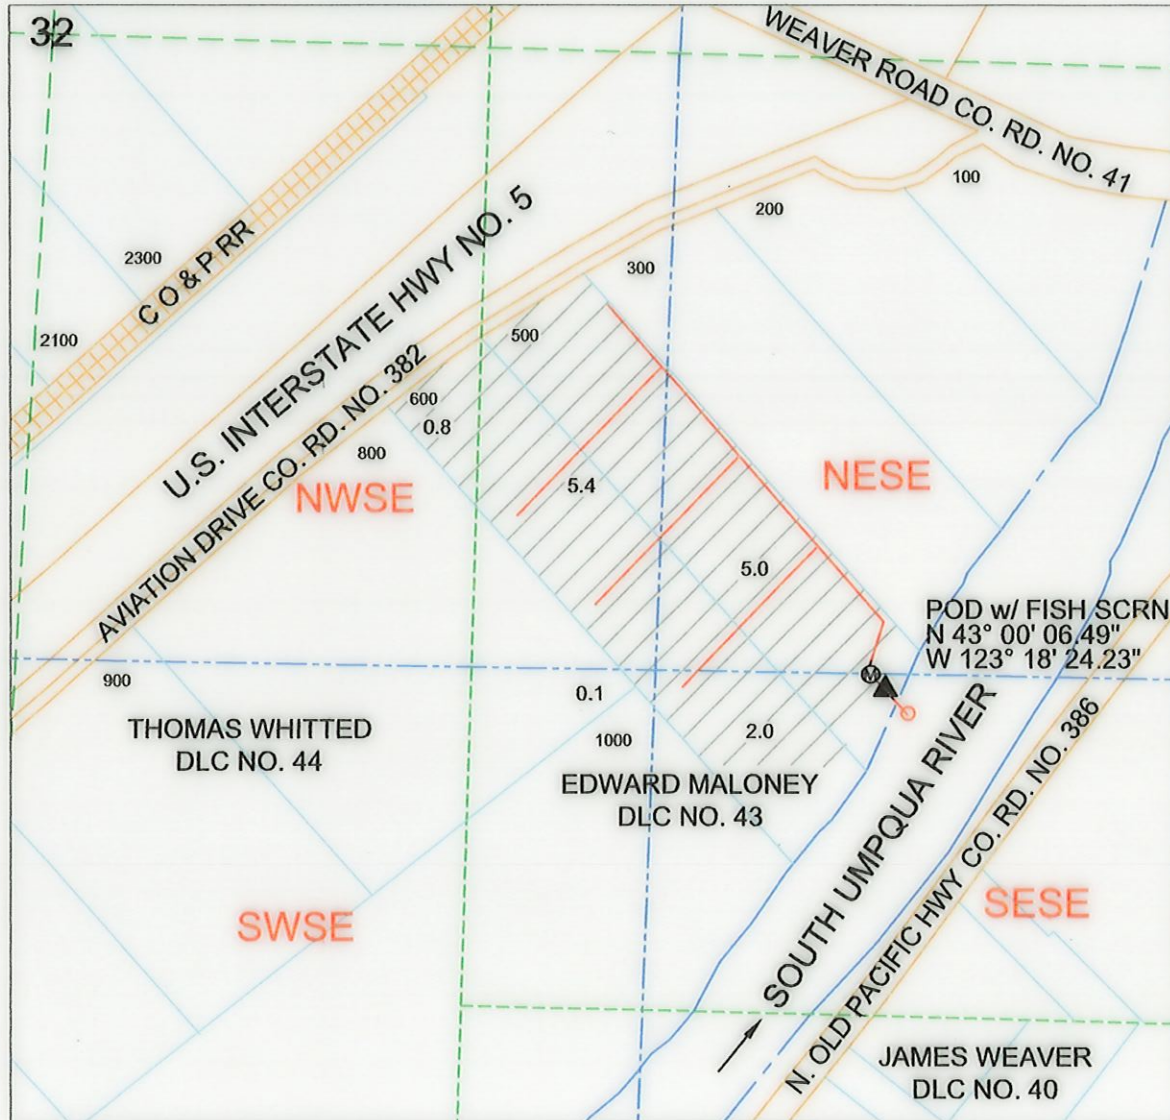

- LEGEND
- WATER/STREAM
 - POD
 - ▲ PUMP
 - ⊙ METER
 - PIPELINE
 - SECTION
 - QUARTER
 - SIXTEENTH
 - DLC
 - PARCEL
 - ▨ SUPPL. GALESVILLE, CERT #66474, 8-5-1983

RECEIVED
 SEP 1 1 2023
 OWRD



POD IS LOCATED 1285 FEET SOUTH AND 1885 FEET EAST FROM C1/4 CORNER, SECTION 32 WITHIN DLC NO. 43.

MAP PREPARED FOR:
 RICK & GAIL WEAVER
 419 WEAVER ROAD
 MYRTLE CREEK, OR 97457

THE PURPOSE OF THIS MAP IS TO IDENTIFY THE LOCATION OF THE WATER RIGHT. IT IS NOT INTENDED TO PROVIDE INFORMATION RELATIVE TO THE LOCATION OF PROPERTY OWNERSHIP BOUNDARY LINES.

MAP PREPARED BY:
 NATHAN REED PE, CWRE
 157 WEST BODIE STREET
 ROSEBURG, OR 97471