
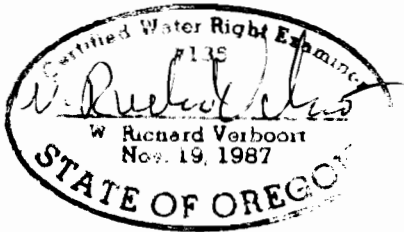


SECTION 11 T.2S., R.4W., W.M.  
YAMHILL COUNTY

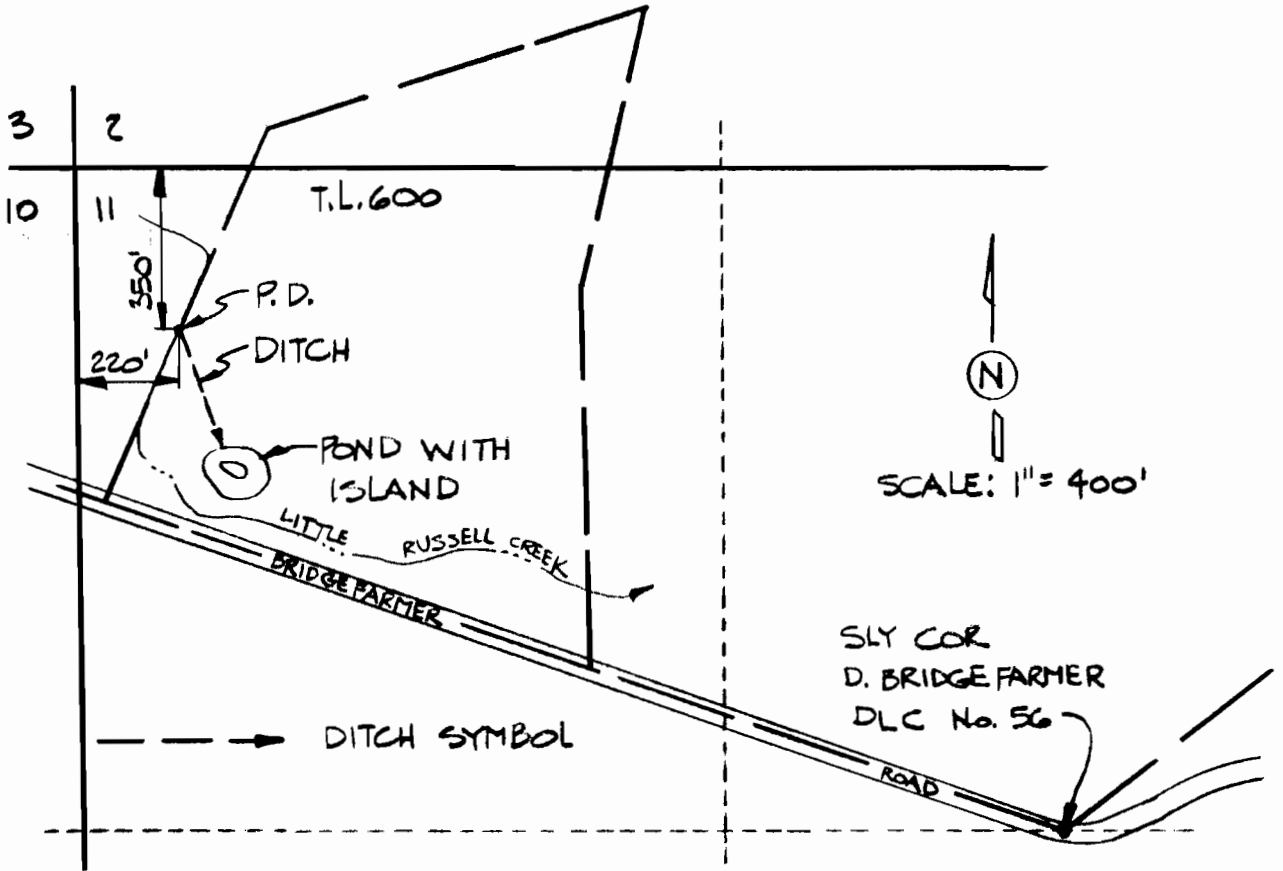

THIS DRAWING IS FOR THE  
PURPOSE OF VERIFYING THE LOCATION OF  
THE WATER RIGHT ONLY. IT IS NOT INTENT  
TO BE A GUARANTEE OF THE LOCATION OF  
PROPERTY OR BOUNDARIES.

FINAL PROOF SURVEY

APPLICATION  
R-70637

PERMIT  
R-11349

SURVEYED FEBRUARY 27, 1993

VERBOORT ENGINEERING  
AGRICULTURE • CIVIL • WATER RESOURCES  
HILLSBORO, OREGON

designed by date  
drawn JER 3/93  
checked WRV 3/93  
drawing no. 93-A-02  
sheet no. 1/1

WILLIAM L. KELLEY  
3500 BRIDGE FARMER RD.  
GASTON, OR 97119