


# T6S, R4W, WM

POLK COUNTY

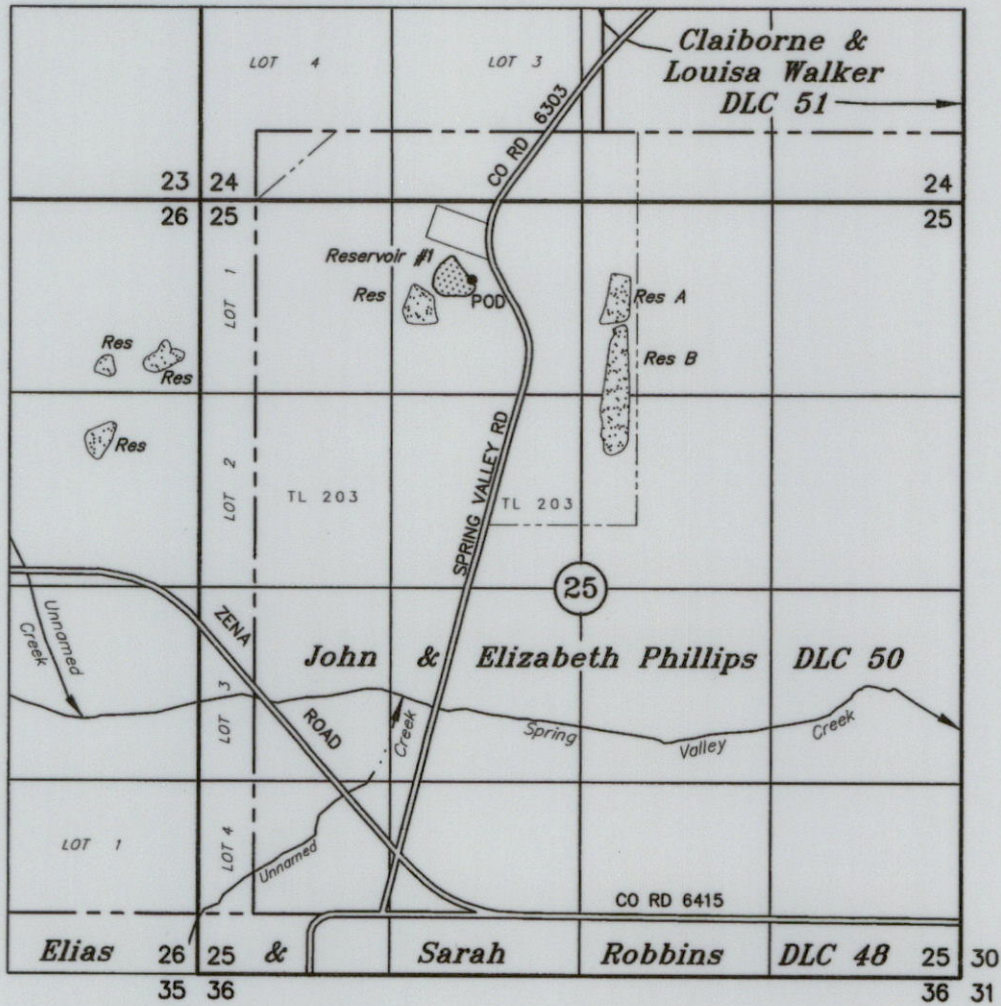

TAX LOT:  
6 4 25 203

RESERVOIR #1 DAM: 545' S & 1900' E OF THE NW COR SEC 25

## CLAIM OF BENEFICIAL USE

UNDER


Application No. R-85598 Permit No. R-13984

RECEIVED  
SEP 13 2023  
OWRD

IN THE NAME OF

**DAVID KNIELING**

September 11, 2018  
SCALE: 1" = 1320'

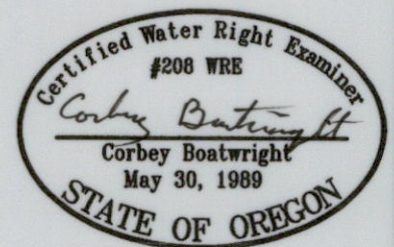

NOTE: This map is not intended to provide legal dimensions or locations of property ownership lines.

Renewal Date 12-31-23