


T6S, R4W, WM

POLK COUNTY

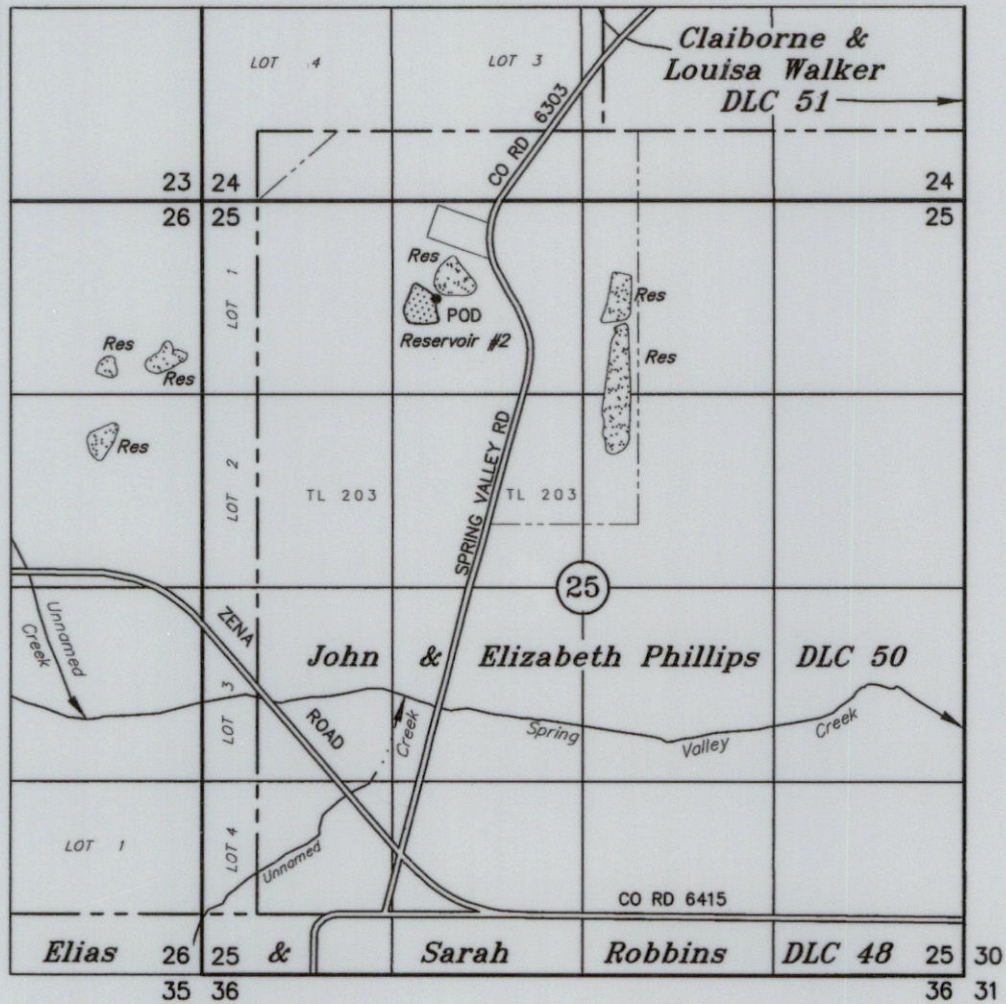

TAX LOT:
6 4 25 203

RESERVOIR #2 DAM: 670' S & 1620' E OF THE NW COR SEC 25

RECEIVED

CLAIM OF BENEFICIAL USE

SEP 13 2023

UNDER

OWRD


Application No. R-85599

Permit No. R-13985

IN THE NAME OF

DAVID KNIELING

September 11, 2018
SCALE: 1" = 1320'

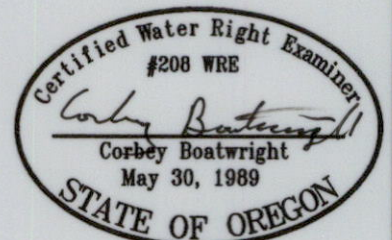

NOTE: This map is not intended to provide legal dimensions or locations of property ownership lines.

Renewal Date 12-31-23