




Claim of Beneficial Use - Transfer T-13212  
 Quiet Meadow Farms


Township 10S, Range 2W, W.M.

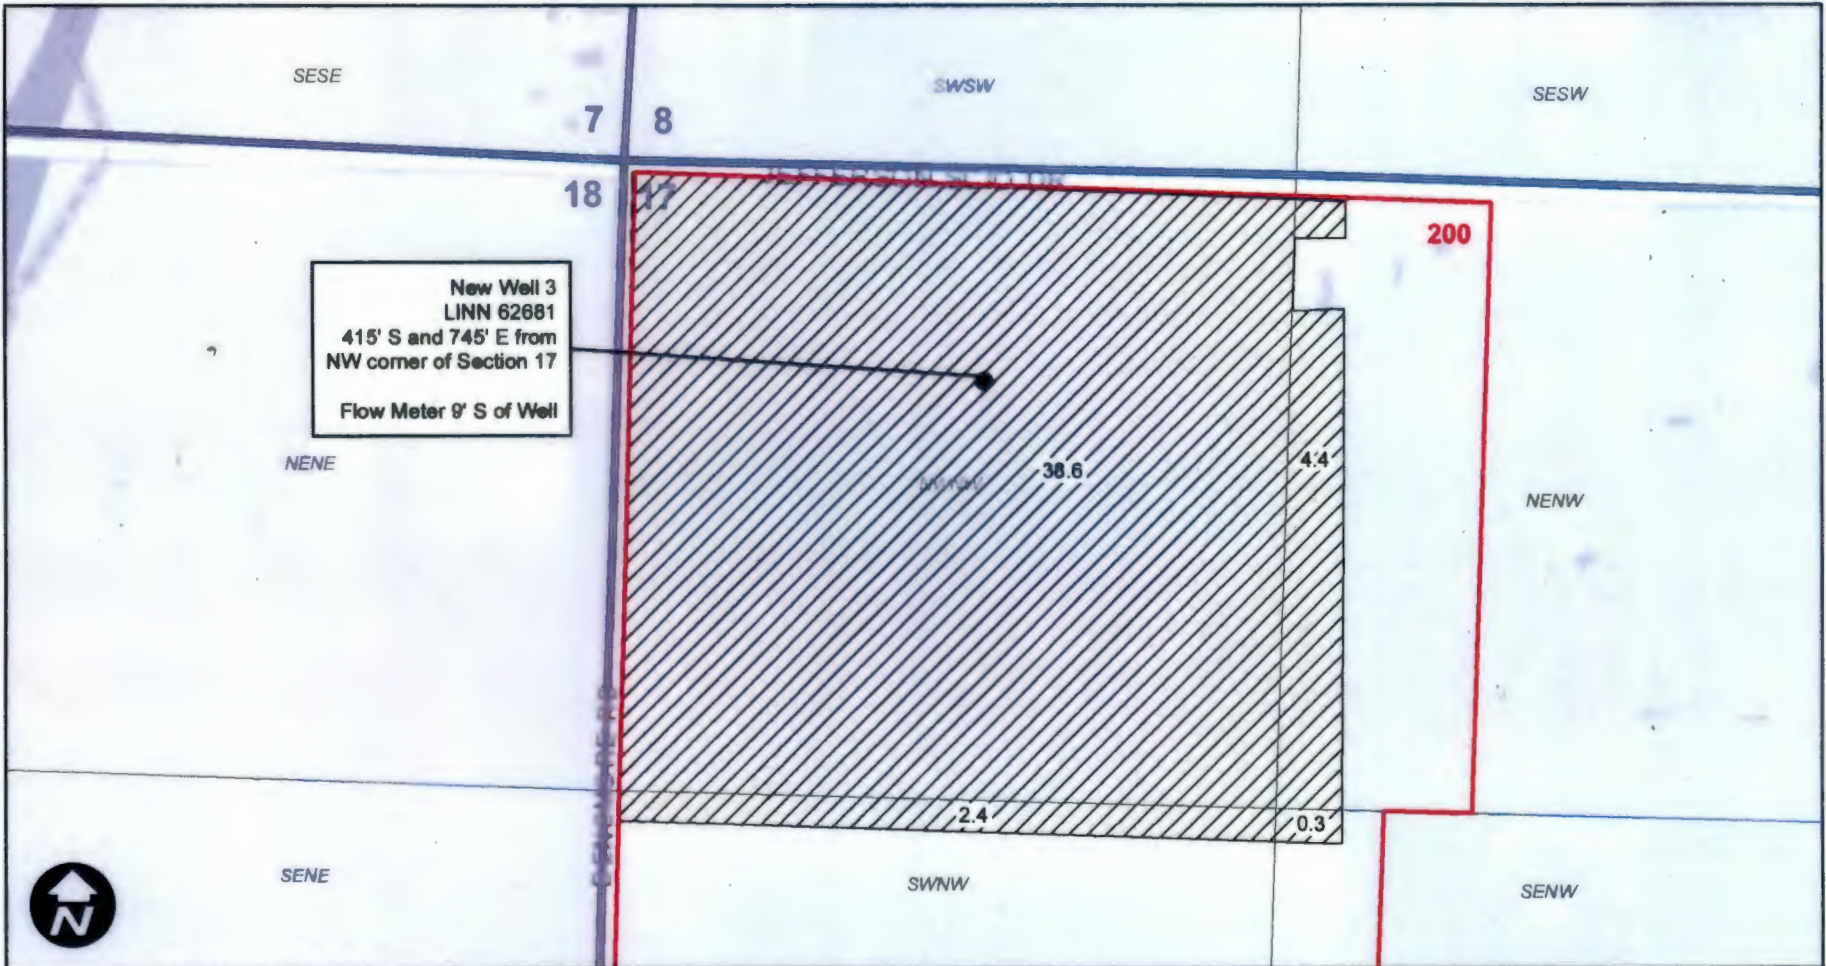

This map is not intended to provide legal dimensions or locations of property ownership lines.

**Legend**

-  T-13212 POU
-  Taxlot

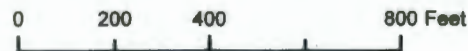

EXPIRES: 12-31-2024