
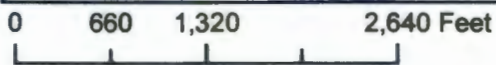


Claim of Beneficial Use - Kraft


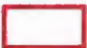


Application G-17889, Permit G-18269

Township 7S, Range 2W, W.M.

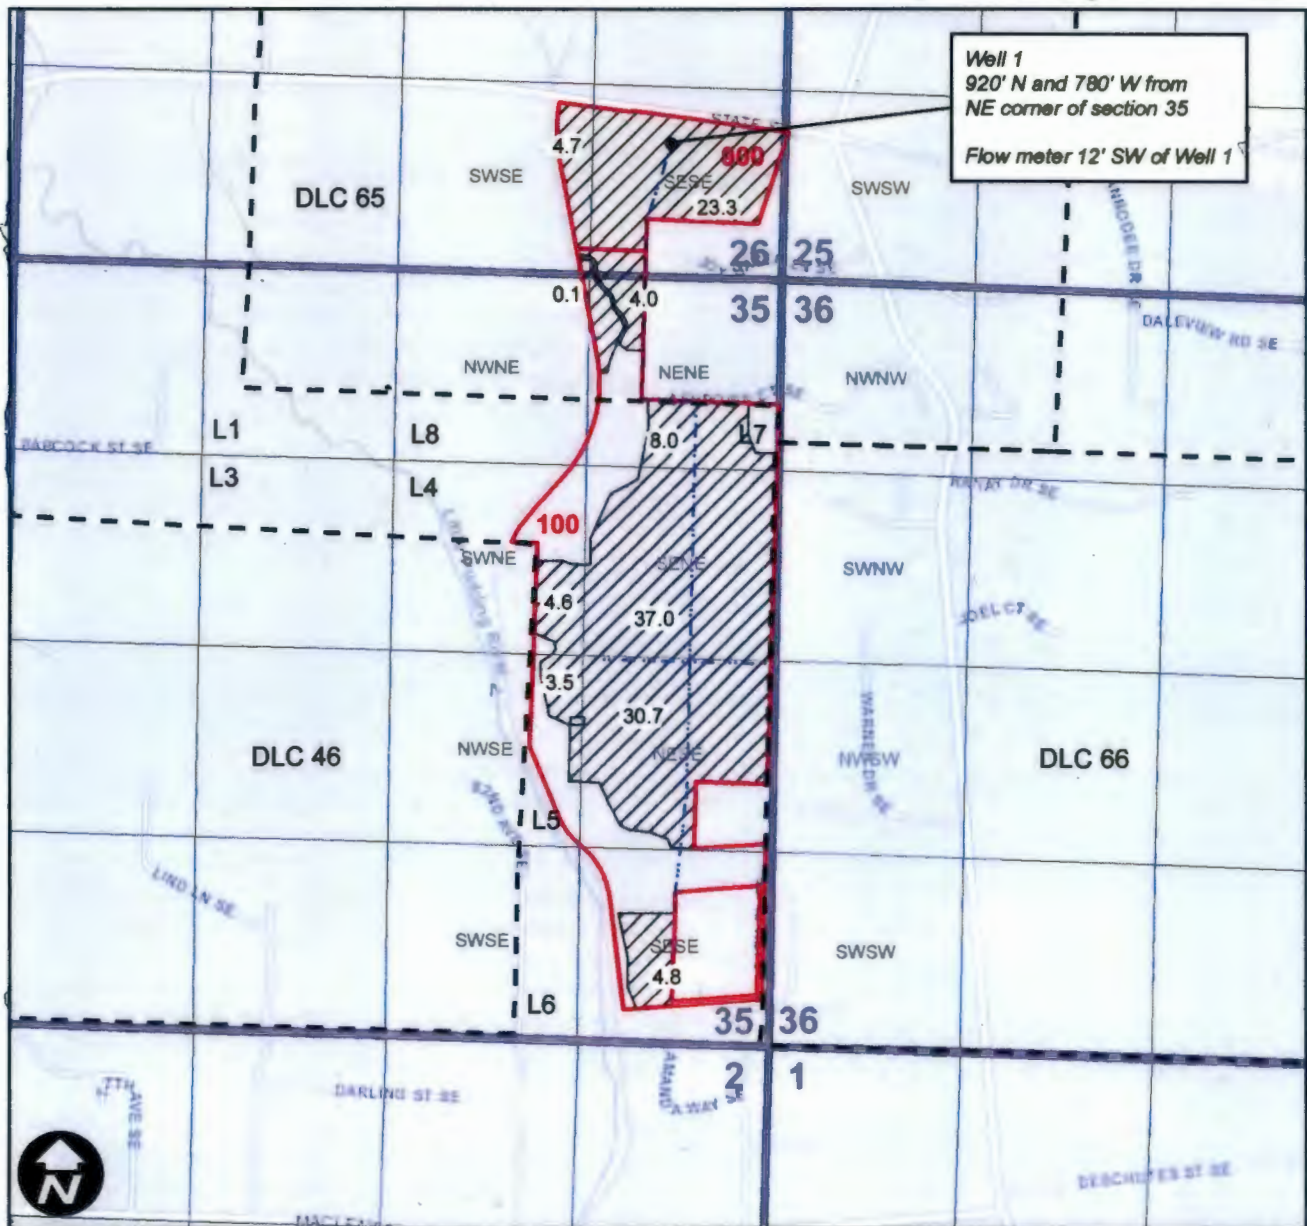

This map is not intended to provide legal dimensions or locations of property ownership lines.

Legend

-  Place of Use
-  Taxlots
-  Mainline
-  DLC



EXPIRES: 12-31-2024