


# Claim of Beneficial Use Map

Section 29 & 32, T4S, R1W, Marion County  
 Transfer T-13493 (Cert. 85763)

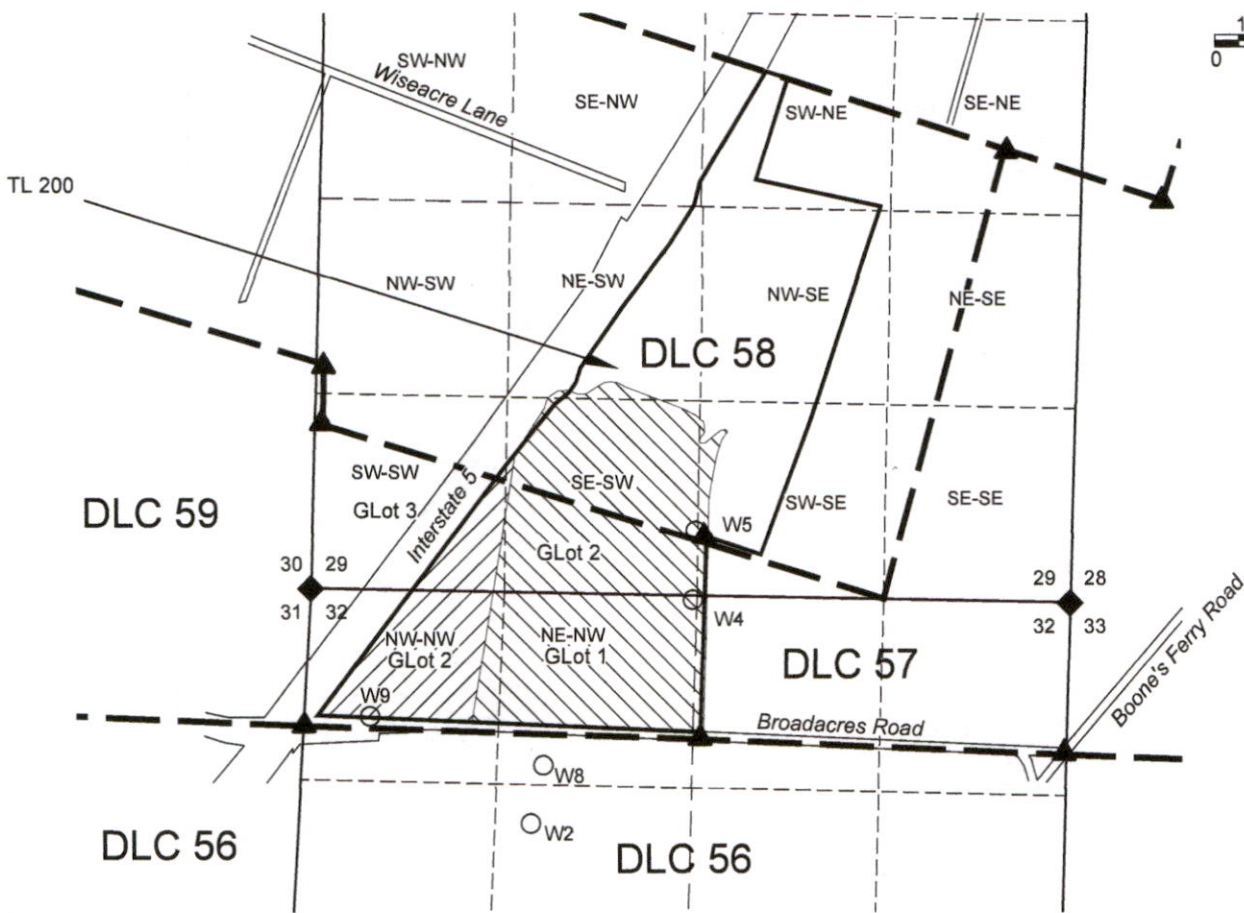


1 IN = 1320 FT  
 0 660 1320



**NOTES:**  
 THIS MAP IS NOT INTENDED TO PROVIDE LEGAL DIMENSIONS OR LOCATIONS OF PROPERTY OWNERSHIP LINES.  
 -PROPERTY LINES, QUARTER-QUARTER AND DONATION LAND CLAIM (DLC) LINES ARE BASED ON THE TAX ASSESSOR MAP FOR SECTION 29, T4S, R1W.  
 -WATER CONVEYANCE LINES SHALL BE ALL WITHIN THE PROPERTY AND THEREFORE ARE NOT SHOWN.

**LOCATIONS OF POA'S:**  
 WELL #4 70' S & 2750' E of SW S29\*  
 WELL #5 370' N & 2750' E of SW S29\*  
 WELL #8 1380' N & 920' W of C1/4 S32\*  
 WELL #9 875' S & 405' E of NW S32.  
 \* PER CERTIFICATE

- LEGEND**
- ▲ DONATION LAND CLAIM (DLC) CORN
  - ◆ SECTION CORNER
  - POINT OF APPROPRIATION (WELL)
  - - - - - STREAM OR SURFACE DRAINAGE
  - — — — — TAX LOT LINE
  - — — — — SECTION LINE
  - - - - - QUARTER-QUARTER LINE
  - - - - - DLC LINES
  - IRRIG (85763 PRIMARY)  
 SUPPL (TO 85761)

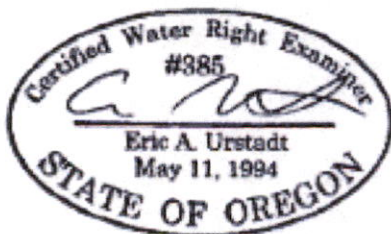

RECEIVED

SEP 25 2023

OWRD

MAP BY:  
**ASPEN RURAL LAND CONSULTING**  
 ERIC URSTADT, PE, PLS  
 971-250-1520  
 Jun2020  
 OT&T-Triangle3A