


NOTES

1. This map was prepared for the purpose of identifying the location of water rights only and is not intended to provide legal dimensions or locations of property ownership lines.
2. COBU site visit and well test Sept. 19, 2017.

CLAIM OF BENEFICIAL USE MAP
TAX LOT 901
 Located in NE-NW
 of Section 23, T.5N., R.36E., W.M.
 Umatilla County, Oregon

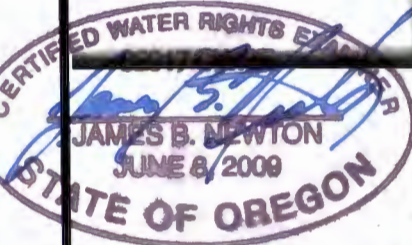


**18.672 Ac Irrigated /
 20.05 Ac on Border**

39.0'

450.0'

21.00

Area Type	Acres
Parking/Bldg	0.231
Onfarm Roads	1.147
Total Non-Irr	1.378
Total Irrigated	18.672
Total Acres	20.050

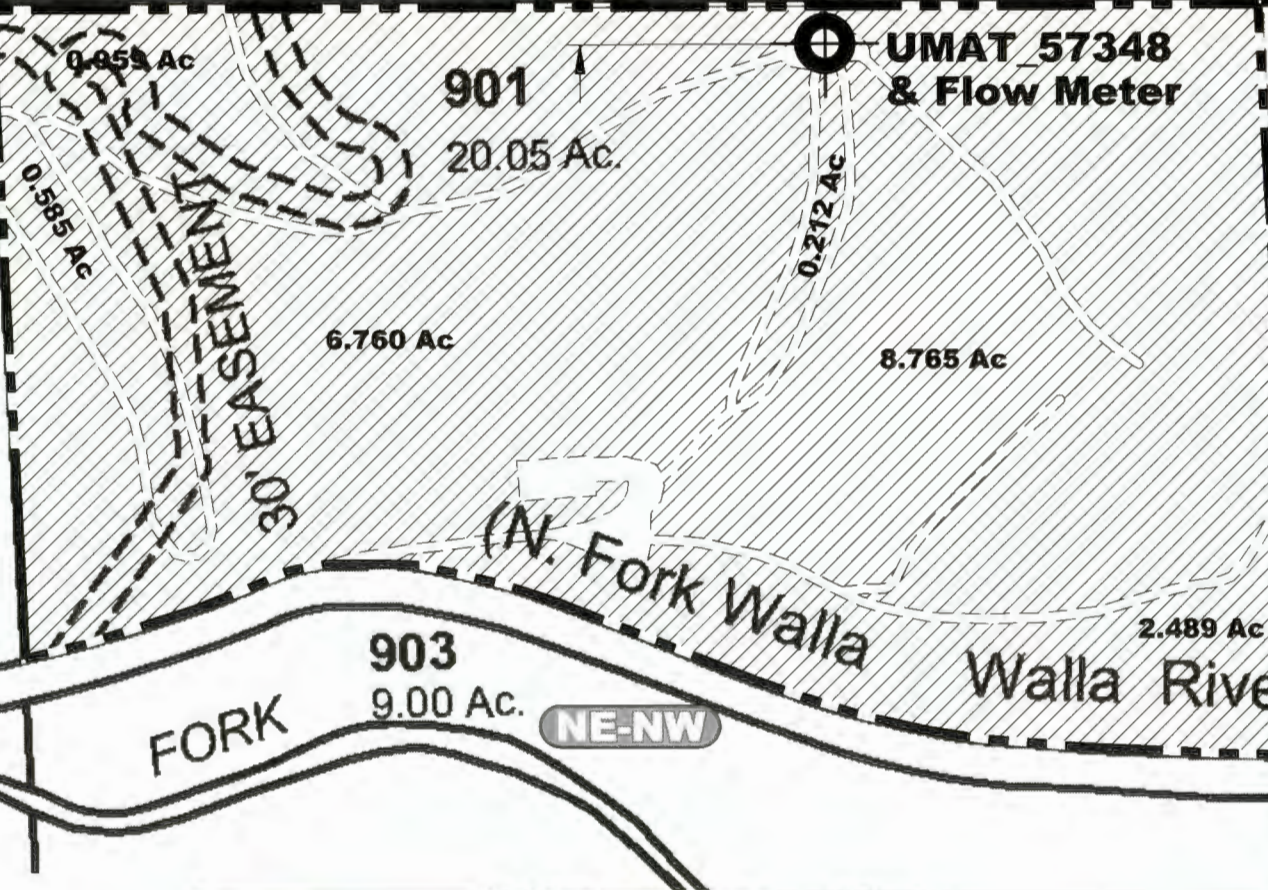

200
28.00 Ac

RECEIVED
 SEP 29 2023
 OWRI

7-

NW-NE

S 88° 24' E

248.82'



SCALE: 1" = 200'



COBU Map
 Capri Walla Walla - Permit G-17135
 Umatilla County, Oregon

DESIGNED BY: J. Newton	DRAWN BY: R2D	DATE: Feb 2023	PROJECT NO. 1008-101	FIGURE 1
---------------------------	------------------	-------------------	-------------------------	-------------