

# Request for Assignment

OREGON



WATER RESOURCES DEPARTMENT

Oregon Water Resources Department  
725 Summer Street NE, Suite A  
Salem, Oregon 97301-1266  
(503) 986-0900  
[www.oregon.gov/owrd](http://www.oregon.gov/owrd)

If the Department determines that the application is incomplete, fees have not been paid, or the required documents are not acceptable, the application and all fees submitted will be returned to the applicant.

If for multiple rights, a separate form and fee for each right will be required.

I, RATZLAFF TRS

(Name of Current Holder of Record)

391 Stillwater

(Mailing Address)

Roseburg OR 97470

(City) (State) (Zip)

(Phone #)

RECEIVED

JUN 26 2023

OWRD

hereby assign all my interest in and to the entire application/permit/transfer order/limited license/groundwater statement; (example, sold all the land authorized under the right)

hereby assign all my interest in and to a portion of application/permit/transfer order/limited license/groundwater statement; (You must include a map showing the portion of the application/permit/transfer order/limited license/groundwater statement to be assigned. Example, sold a portion of the land authorized under the right)

hereby assign a portion of my interest in and to the entire application/permit/transfer order/limited license/groundwater statement; (example, adding an additional person)

Application # S-89179; Permit # S-55369; Transfer Order # \_\_\_\_\_;

Limited License # \_\_\_\_\_; Groundwater Statement # \_\_\_\_\_;

as filed in the office of the Water Resources Director, to:

Patricia A & Keith J. LEE

(Name of New Owner)

588 Stillwater Road Roseburg OR 97470 5415800275

(Mailing Address)

(City) (State) (Zip)

(Phone #)

email: pklee2@icloud.com

**Note:** If there are other owners of the property described in the application, permit, transfer order, limited license, or groundwater statement, you must provide a list of all other owners' names and mailing addresses and attach it to this form. Write the initials (first letters) of your first and last names at the spot indicated below.

pklee I hereby certify that I have notified all other owners of the property described in this application, permit, transfer order, limited license, or groundwater statement of this Request of Assignment.

Witness my hand this 5<sup>th</sup> day of June, 2023.  
(Day) (Month) (Year)

Signature of Current Holder of Record Jane P. Ratzlaff

**Failure to provide any of the required information will result in the return of your application.**

This certifies assignment and record change at Oregon Water Resources Department effective 8:00 a.m. on date of receipt at Salem, Oregon.

Fee receipt # 141583

For Director by Mary F. Bjork, Program Analyst in Water Rights Division. MFB

The completed "Request for Assignment" form **must** be submitted to the Department along with the recording fee of \$120.

RECEIVED

SEP 07 2023

OWRD

Part Assign - Approve  
MFB 9-14-2023




**Surface Water Application Map**  
**Ratzlaff**  
**T.26s R5w Section 25**  
**Douglas County**

Scale: 1" = 400

RECEIVED

03 2021

OWRD

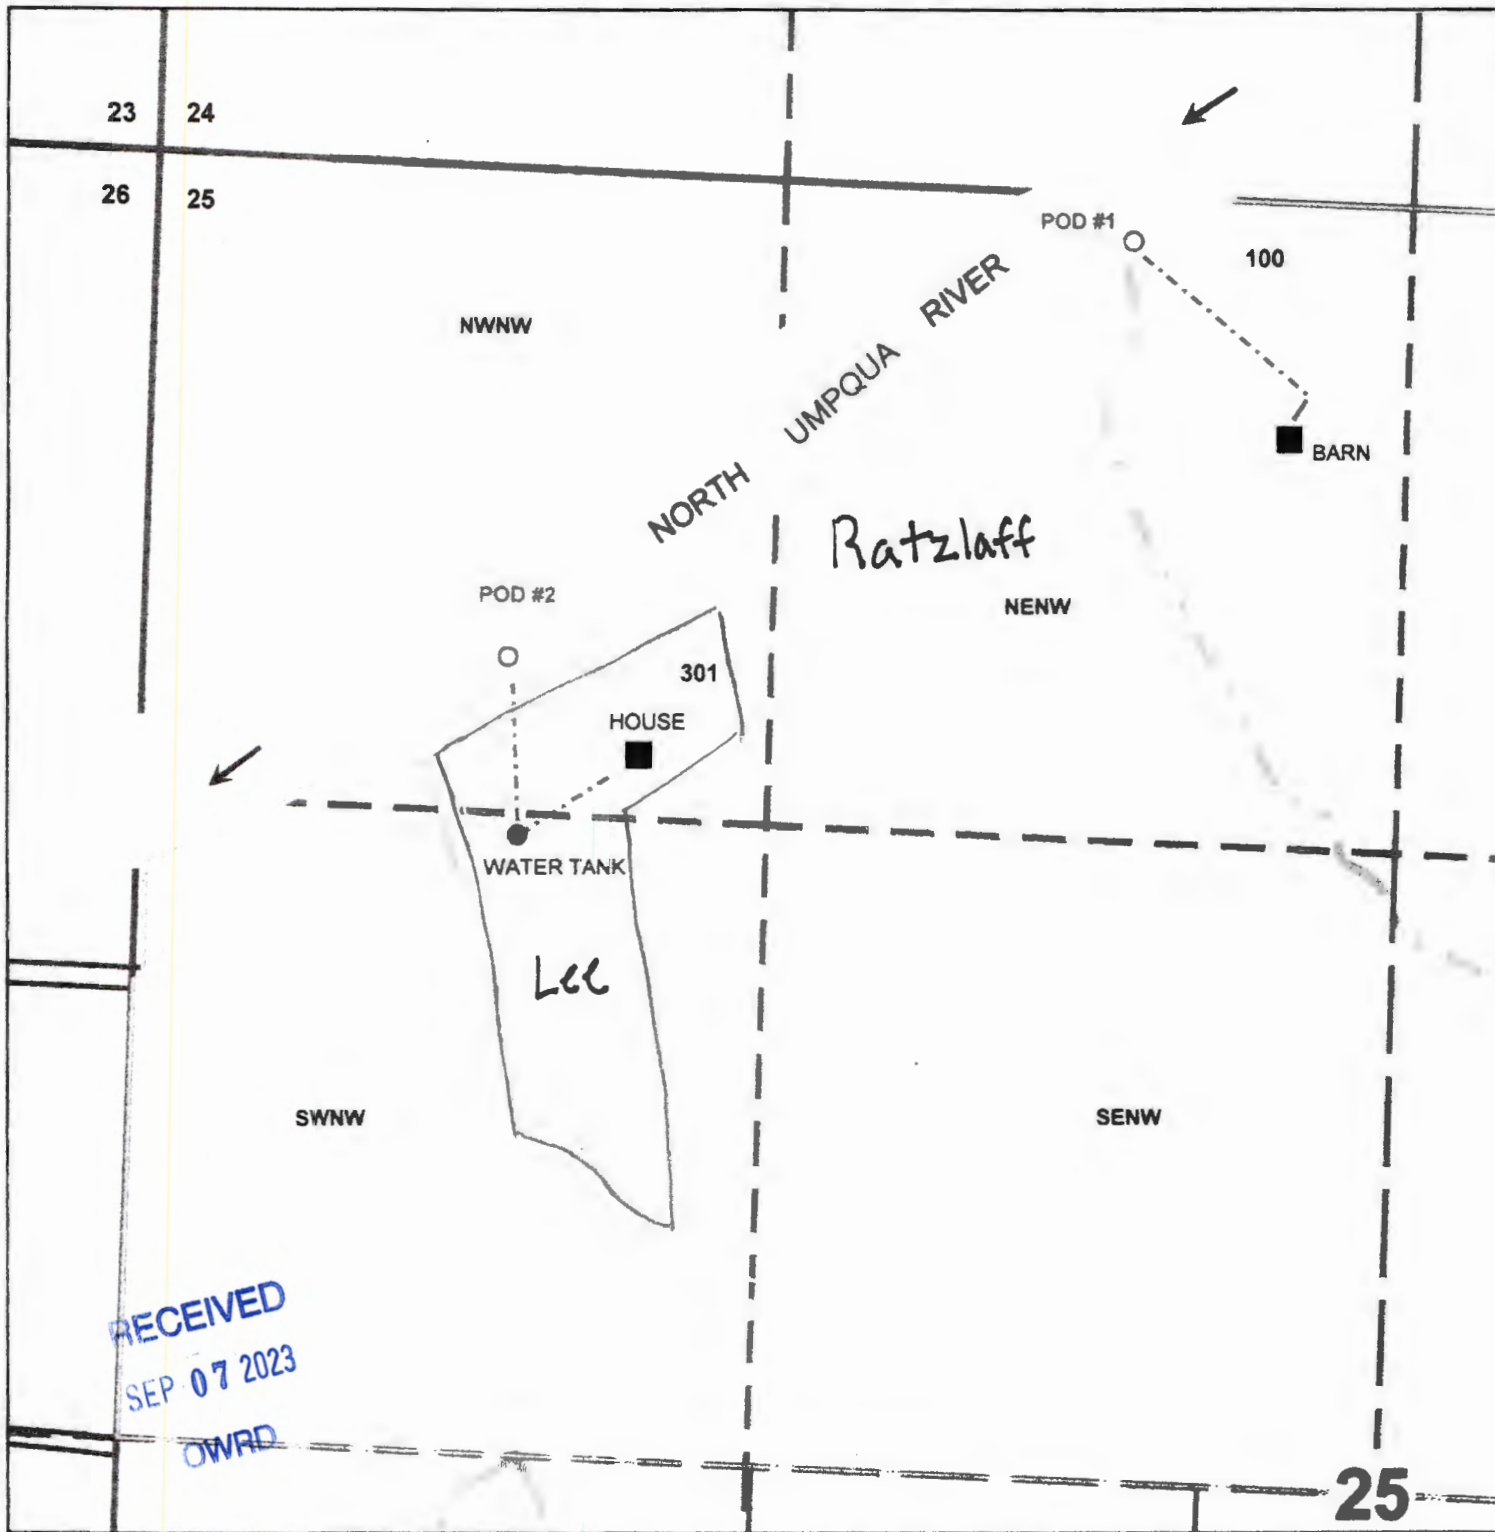

RECEIVED  
SEP 07 2023  
OWRD

**Point of Diversion #1 is 97 ft South and 2,038 ft East from the  
NW 1/4 Corner of Section 25**

**Point of Diversion #2 is 1,005 ft South and 800 ft East from the  
NW 1/4 Corner of Section 25**