


# CLAIM OF BENEFICIAL USE MAP


FOR  
**JACK SPARROWK**  
 SECTION 16, 17, 20, 21,  
 28 & 29, T38S R17E W.M.  
 LAKE COUNTY, OREGON

- LEGEND**
- SECTION LINE
  - 1/4 SECTION LINE
  - 1/16 SECTION LINE
  - MAINLINE
  - - - WATERWAY/DITCH

APPLICATION NO. G-13313  
 PERMIT NO. G-17289  
 TRANSFER NO. T-11817

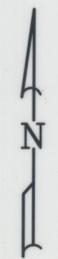


SCALE: 1"=1320'

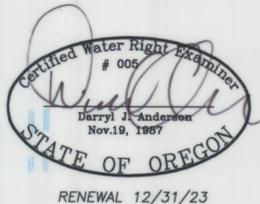

RECEIVED  
**SEP 30 2023**  
 OWRD

RECEIVED  
**AUG 21 2023**  
 OWRD

NOTE:  
 PREPARATION OF THIS MAP IS FOR IDENTIFYING WATER RIGHTS ONLY. IT HAS NO INTENT TO PROVIDE LOCATIONS OR DIMENSIONS OF PROPERTY BOUNDARIES.

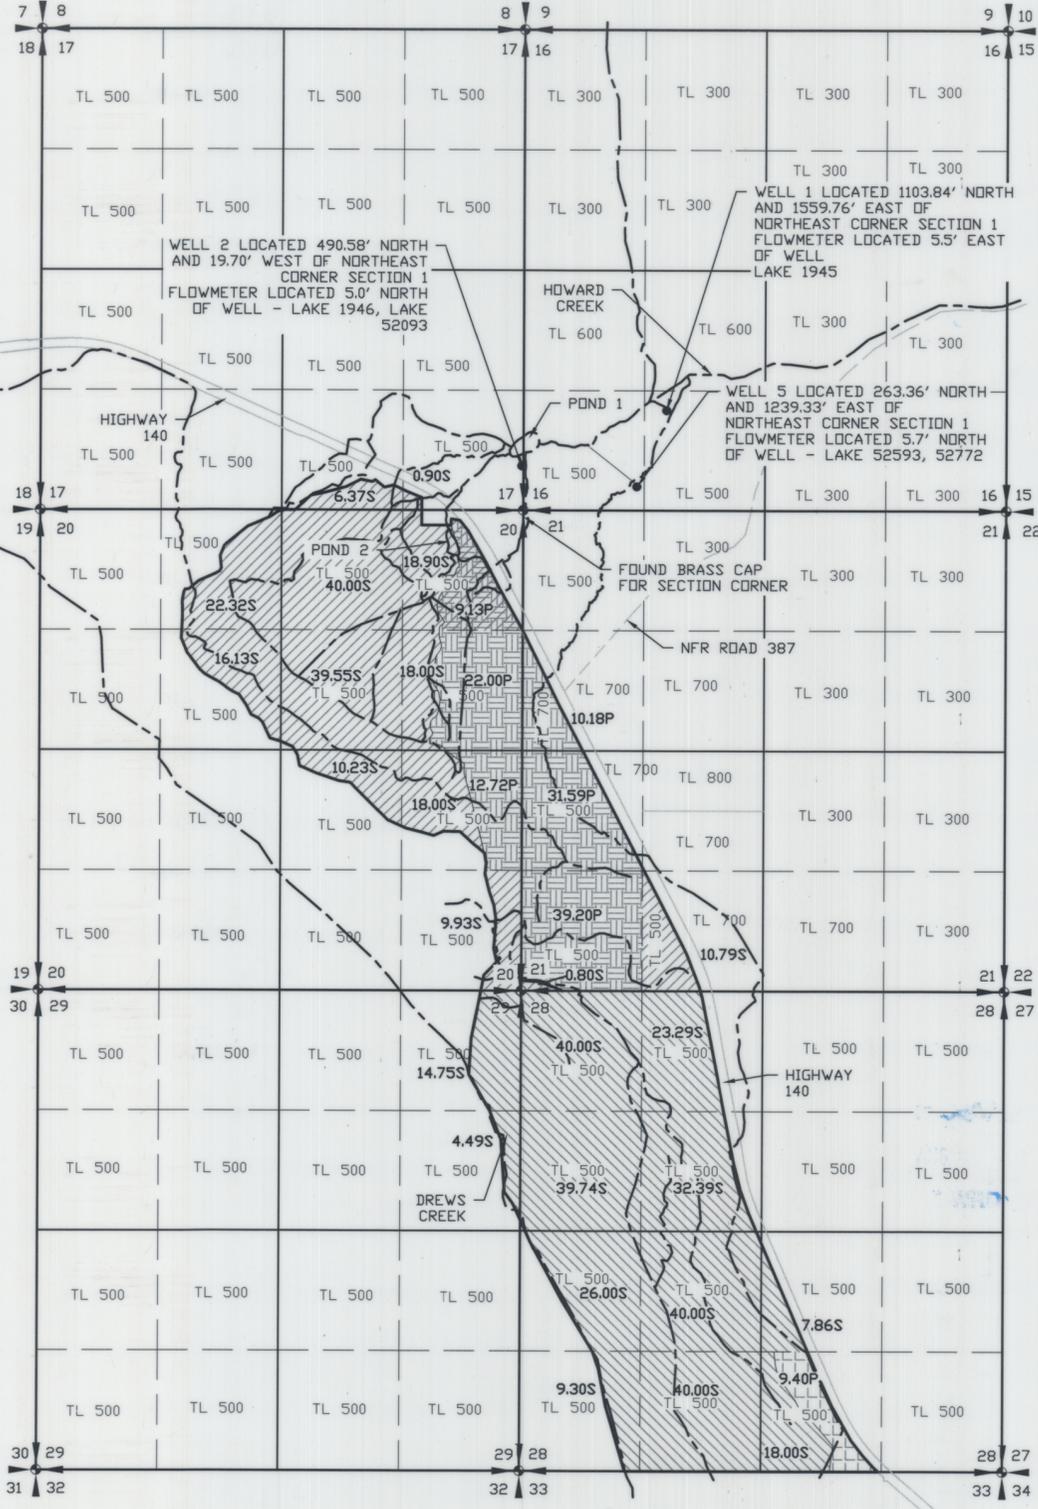

- PRIMARY WELL 1 & 5
- SUPPLEMENTAL WELL 1 & 5
- PRIMARY WELL 2 & 5
- SUPPLEMENTAL WELL 2 & 5

PREPARED FOR:  
 JACK SPARROWK  
 P.O. BOX 657  
 CLEMENTS, CA 95227

PREPARED BY:  
**ANDERSON ENGINEERING & SURVEYING, INC.**  
 P.O. BOX 28  
 LAKEVIEW, OREGON 97630  
 (541) 947-4407 / FAX 947-2321  
 WWW.ANDERSONENGINEERING.COM

DATE: 08/02/2023      DWG. FILE: 2022-119  
 JOB NO.: 2022-119      SHEET 1 OF 1