



Oregon Water Resources Department
 725 Summer Street NE, Suite A
 Salem, Oregon 97301
 (503) 986-0900
 www.oregon.gov/OWRD

Ownership Update for Certificated Rights Only

NO FEES ARE REQUIRED TO SUBMIT THIS FORM

NOTICE: A certificate of water right typically stays with the land. In order to track water right ownership, the Department requests that this form be submitted to the Department. **To update multiple rights, a separate form is required for each right.** If you have any questions about this form, please contact your local watermaster, or call the Water Resources Department at (503) 986-0900.

This form is **not** for Applications, Permits, Transfers, Groundwater Registrations, or Limited Licenses. To notify the Department of changes in ownership to these types of authorizations, an Assignment is required.

Current Landowner Information					
Name:	Bruce Norman Nelson				
Mailing Address:	4947 Lake Dr.				
City:	Florence	State:	Oregon	Zip:	97439
Phone:	253-691-8235	Email:	kakebaby@aol.com		

Property Information					
County:	Lane County	Township:		Range:	
Tax Lot #:	19-12-15-40-01500				
Street Address of Water Right:	4947 Lake Dr. Florence, Oregon 97439				
Water Right Information					
Application:	Update to New Owner				
Permit:	# 39626 - # 26567 - domestic & Irrigation				
Certificate:	# 48618				
Are all the lands associated with this water right owned by the requestor? <input checked="" type="checkbox"/> Yes <input type="checkbox"/> No					
(If no, include a map showing the portion of the water right involved)					

Signature and Date	
Name of individual completing form:	Bruce Norman Nelson
Signature of requestor:	<div style="display: flex; justify-content: space-between;"> <i>Bruce N. Nelson</i> Date: 9-10-23 </div>
Phone or email:	kakebaby@aol.com

The Department does not change names on water right certificates. This form will be placed in the file for future reference only. If mailed, the Department will not provide acknowledgement of receipt.

This form can be mailed to the address above or sent via email to wrd_dl_customerservice@oregon.gov

RECEIVED

SEP 22 2023

OWRD



Oregon Water Resources Department
725 Summer Street NE, Suite A
Salem, Oregon 97301
(503) 986-0900
www.oregon.gov/OWRD

Ownership Update for Certificated Rights Only

NO FEES ARE REQUIRED TO SUBMIT THIS FORM

NOTICE: A certificate of water right typically stays with the land. In order to track water right ownership, the Department requests that this form be submitted to the Department. **To update multiple rights, a separate form is required for each right.** If you have any questions about this form, please contact your local watermaster, or call the Water Resources Department at (503) 986-0900.

This form is **not** for Applications, Permits, Transfers, Groundwater Registrations, or Limited Licenses. To notify the Department of changes in ownership to these types of authorizations, an Assignment is required.

Current Landowner Information					
Name:	Christina M Nelson				
Mailing Address:	4947 Lake Dr.				
City:	Florence	State:	Oregon	Zip:	97439
Phone:	253-691-8235	Email:	kakebaby@aol.com		
Property Information					
County:	Lane County	Township:		Range:	
Tax Lot #:	19-12-15-40-01500				
Street Address of Water Right:	4947 Lake Dr. Florence Oregon 97439				
Water Right Information					
Application:	Update to New ownership				
Permit:	#39626 - #26567 = domestic & Irrigation				
Certificate:	# 48618				
Are all the lands associated with this water right owned by the requestor? <input checked="" type="checkbox"/> Yes <input type="checkbox"/> No					
(If no, include a map showing the portion of the water right involved)					

Signature and Date	
Name of individual completing form:	Christina M Nelson
Signature of requestor:	Christina M Nelson Date: 9-10-23
Phone or email:	kakebaby@aol.com

The Department does not change names on water right certificates. This form will be placed in the file for future reference only. If mailed, the Department will not provide acknowledgement of receipt.

This form can be mailed to the address above or sent via email to wrd_dl_customerservice@oregon.gov

07-01-2022 TO 06-30-2023 REAL PROPERTY TAX STATEMENT
LANE COUNTY 125 E. 8TH AVE. EUGENE, OR 97401 (541) 682-4321

www.lanecounty.org/at

SITUS ADDRESS: 4947 LAKE DR
 FLORENCE, OR 97439

PROPERTY CLASS: 409
 TAX CODE AREA: 09707 ACRES: 0.26
 MAP & TAX LOT : 19-12-15-40-01500

NELSON VERONIQUE E
 1920 WILLOW ST
 FLORENCE, OR 97439

ACCOUNT # 0865301

LAST YEAR'S TAX 2,559.99
 See back for explanation of taxes marked with (*)

CURRENT TAX BY DISTRICT

U Lane Community College	149.26
U Lane Education Service Dist	53.81
U Siuslaw School District	938.52
Siuslaw School District LO	180.82
Education Totals:	1,322.41
U Siuslaw Public Library Dist	124.47
Lane County 4-H /Extension LO	6.75
Lane County Public Safety LO	132.60
U Port of Siuslaw	35.54
U Siuslaw Valley Fire & Rescue	371.69
U Western Lane Ambulance Dist	77.10
Western Lane Ambulance Dist LO	108.49
U Lane County	308.43
General Government Totals:	1,165.07
U Lane Community College Bond III	25.60
Fire Patrol - West	18.75
Fire Patrol Emergency - West	47.50
U Lane Community College Bond II	53.71
Bonds - Other Totals:	145.56

VALUES AS OF 01/01/2022	LAST YEAR	THIS YEAR
REAL MARKET VALUE		
LAND	94,576	105,712
STRUCTURES	281,220	372,953
TOTAL	375,796	478,665
M5 SPECIAL ASSESSED VALUE	0	0
M5 REAL MKT VALUE ASSESSED VALUE	375,796	478,665
EXEMPTIONS	234,068	241,090
TAXABLE VALUE	234,068	241,090

MORTGAGE CO:
 If a mortgage company pays your taxes,
 this statement is for your records only.

TAX PAYMENT OPTIONS
 (See back of statement for payment instructions)

	Pay By	Discount	Net Amount Due
In Full	11/15/2022	78.99	2,554.05
2 / 3	11/15/2022	35.10	1,720.26
1 / 3	11/15/2022		

2022-2023 TAXES BEFORE DISCOUNT 2,633.04
TOTAL TAX (After Discount) 2,554.05

RECEIVED
SEP 22 2023
OWRD

RECEIVED
MAY 12 2023
OWRD

LOT 1

STATE OF OREGON
COUNTY OF LANE

Nelson, Christina &
Vernique
1920 W. 110th St
Flo, OR
4947 Lake DR

CERTIFICATE OF WATER RIGHT

This Is to Certify, That **VERNON FRANCIS WEBER**

of **Box 158, Florence**, State of **Oregon**, has made proof to the satisfaction of the STATE ENGINEER of Oregon, of a right to the use of the waters of **Washink Lake**

a tributary of _____ for the purpose of **domestic use of 3 families**

under Permit No. **26567** of the State Engineer, and that said right to the use of said waters has been perfected in accordance with the laws of Oregon; that the priority of the right hereby confirmed dates from **February 2, 1960**

that the amount of water to which such right is entitled and hereby confirmed, for the purposes aforesaid, is limited to an amount actually beneficially used for said purposes, and shall not exceed **0.03 cubic foot per second**

or its equivalent in case of rotation, measured at the point of diversion from the stream. The point of diversion is located in the **Lot 6 (SE $\frac{1}{4}$ SE $\frac{1}{4}$)**, Section 15, T. 19 S., R. 12 W., W. M. Diversion point located **662 feet North and 570 feet West** from South meander corner between Section 14 and 15.

The amount of water used for irrigation, together with the amount secured under any other right existing for the same lands, shall be limited to - - - - - of one cubic foot per second per acre,

and shall conform to such reasonable rotation system as may be ordered by the proper state officer.

A description of the place of use under the right hereby confirmed, and to which such right is appurtenant, is as follows:

Lot 6 (SE $\frac{1}{4}$ SE $\frac{1}{4}$)
Section 15
T. 19 S., R. 12 W., W. M.

RECEIVED

SEP 22 2023

OWRD

Per State
POU = lots 1, 11, & 9

The right to the use of the water for the purposes aforesaid is restricted to the lands or place of use herein described.

RECEIVED

MAY 12 2023

OWRD

WITNESS the signature of the State Engineer, affixed this date. **June 28, 1968**

CHRIS L. WHEELER

State Engineer

STATE OF OREGON

COUNTY OF LANE

CERTIFICATE OF WATER RIGHT

This Is to Certify, That CHARLES V. REEVES

of 4947 Lake Drive, Florence, State of Oregon, 97439, has made proof to the satisfaction of the Water Resources Director, of a right to the use of the waters of Woahink Lake

a tributary of Woahink Creek for the purpose of domestic use for one family

under Permit No. 39626 and that said right to the use of said waters has been perfected in accordance with the laws of Oregon; that the priority of the right hereby confirmed dates from October 9, 1974 that the amount of water to which such right is entitled and hereby confirmed, for the purposes aforesaid, is limited to an amount actually beneficially used for said purposes, and shall not exceed 0.005 cubic foot per second

or its equivalent in case of rotation, measured at the point of diversion from the stream. The point of diversion is located in the Lot 6 (SE $\frac{1}{4}$ SE $\frac{1}{4}$), Section 15, T. 19 S., R. 12 W., W. M., 662 feet North and 570 feet West from the South Meander Corner between Sections 14 and 15

The amount of water used for irrigation, together with the amount secured under any other right existing for the same lands, shall be limited to ----- of one cubic foot per second per acre,

and shall conform to such reasonable rotation system as may be ordered by the proper state officer. A description of the place of use under the right hereby confirmed, and to which such right is appurtenant, is as follows:


Lot 6 (SE $\frac{1}{4}$ SE $\frac{1}{4}$)
Section 15
T. 19 S., R. 12 W., W. M.

RECEIVED
SEP 22 2023
OWRD

The right to the use of the water for the purposes aforesaid is restricted to the lands or place of use herein described and is subject to the existing minimum flow policies established by the Water Policy Review Board.

WITNESS the signature of the Water Resources Director, affixed

this date. October 5, 1979

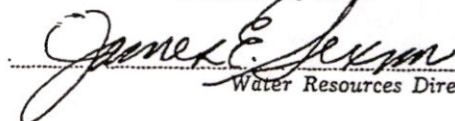

Water Resources Director

RECEIVED

MAY 12 2023

OWRD

Recorded in State Record of Water Right Certificates, Volume 42, page 48618

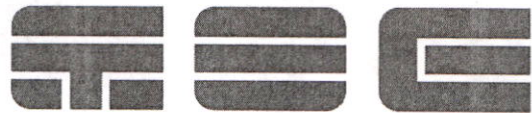

CASCADE TITLE CO.

RECEIVED
MAY 12 2023

OWRD


MAP NO.
19-12-15-40

EAST 004.00

RECEIVED

SEP 22 2023

OWRD

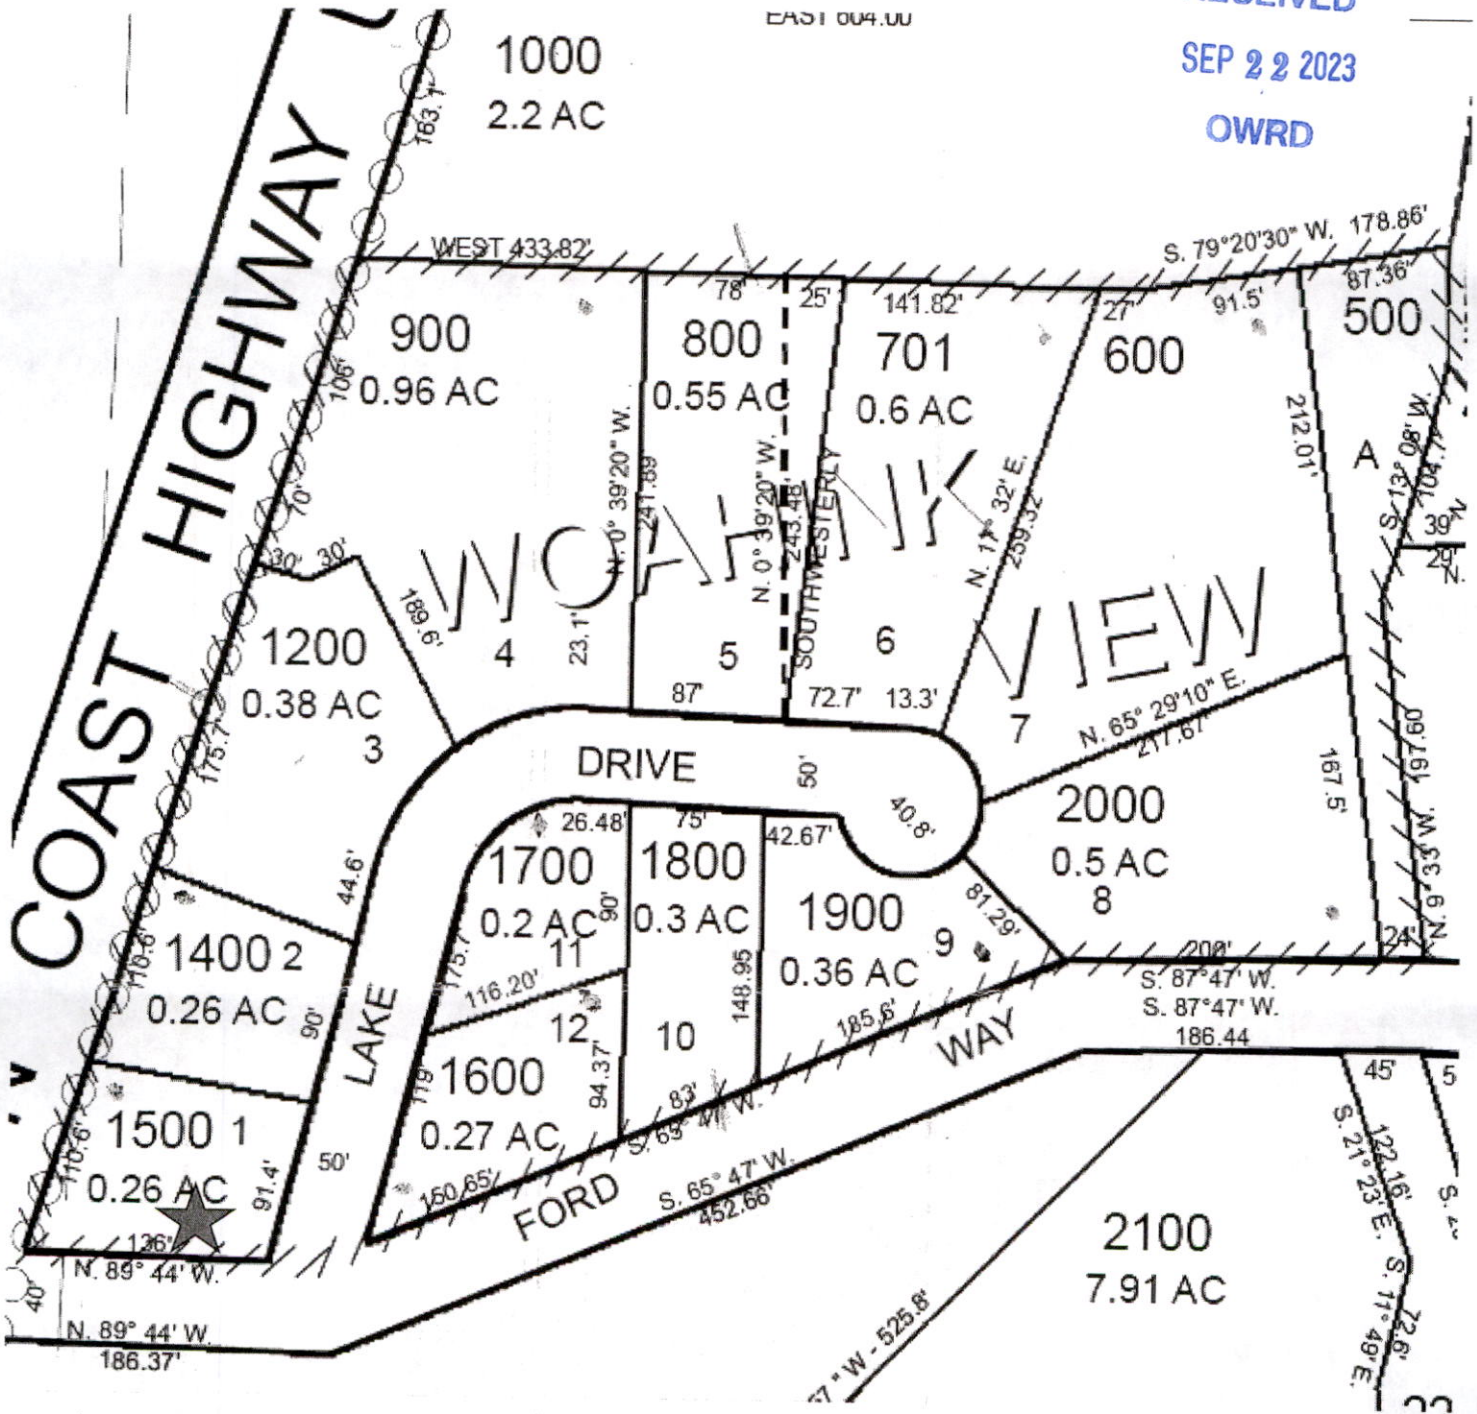

THIS MAP/PLAT IS BEING FURNISHED AS AN AID IN LOCATING THE HEREIN DESCRIBED LAND IN RELATION TO ADJOINING STREETS, NATURAL BOUNDARIES AND OTHER LAND, AND IS NOT A SURVEY OF THE LAND DEPICTED. EXCEPT TO THE EXTENT A POLICY OF TITLE INSURANCE IS EXPRESSLY MODIFIED BY ENDORSEMENT, IF ANY, THE COMPANY DOES NOT INSURE DIMENSIONS, DISTANCES, LOCATION OF EASEMENTS, ACREAGE OR OTHER MATTERS SHOWN THEREON.

initial take - draft only - woahink view area/neighborhood - water right by tax lot

DOUTHIT Susan M * WRD <Susan.M.Douthit@oregon.gov>

Fri 9/3/2021 10:57 AM

To:Dunes City Recorder <recorder@dunescityor.com>;

RECEIVED

MAY 12 2023

OWRD

Hi Jamie!

Nice chatting w/you and the woahink view group the other night

I suspect we'll be hearing from this group following their closed meeting on Saturday.

Lmk what you think of my simplified list below.

Enjoy the weekend.

~S

Tax Lot	WR#
200	48621
1000	93839
500	---
600	48621
701	---
800	---
900	48621
401	---
1200	---
1400	48618<<unsure add'l research needed
1500	35003
1600	48621
1700	35003
1800	----
1900	35003
2000	48621
400	

~S

Watermaster, OWRD
Serving Coos and Douglas Counties
541-440-4255 (Roseburg office)
541-580-4961 (cell)

RECEIVED

SEP 22 2023

OWRD

DISCLAIMER

Water right and well log records provided by the Watermaster's office are based on information available in our files and from Oregon Water Resources Department (OWRD) databases. While we make every effort to insure our information is complete and factual, this office cannot accept any responsibility for errors, omissions, or accuracy of the data. There are no warranties, expressed or implied, including the warranty of merchantability or fitness for a particular purpose, accompanying this information. Official records are available from the OWRD Salem office. For additional assistance, you may contact the OWRD Salem office at 503-986-0900 or on the internet at

<https://www.oregon.gov/owrd/pages/index.aspx>

RECEIVED
MAY 12 2023
OWRD


WOHINK VIEW

SEC. 15, T. 19S, R. 12 WWM, LANE COUNTY, ORE.

CERTIFICATE OF SURVEYOR

RECEIVED
MAY 6 1957
STATE ENGINEER
RALPH STEVENSON

RECEIVED
SEP 22 2023
OWRD

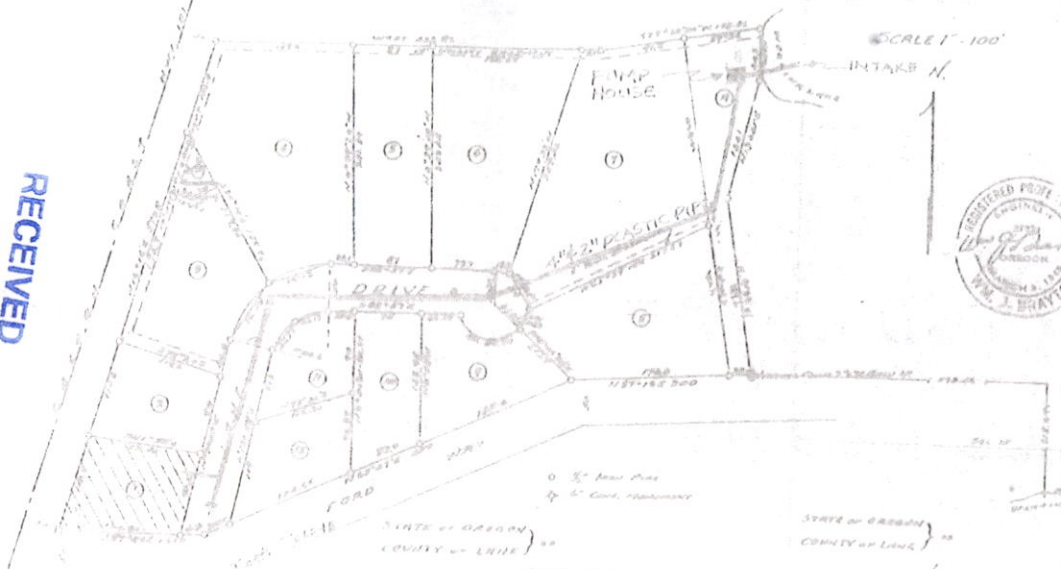

STATE OF OREGON }
COUNTY OF LANE }















Application No. 52489
Permit No. 03040

FILED _____ 1957
County Clerk.

APPROVALS

BY ORDER OF COUNTY CLERK:

Approved _____ 1957
Lane County Health Dept.

Approved Aug 30 1957
C. E. Waddell
County Treasurer.

Approved Aug 30 1957
Winfred M. Smith
County Treasurer.

BY ORDER OF LANE COUNTY PLANNING COMMISSION:

Approved _____ 1957
STEPHEN H. FORD
COMMISSION ACTING
HOWARD W. BURDORF
SECRETARY.

Approved _____ 1957
ROBT W. STUBBS
COMMISSIONER.

RALPH PETERSON
COMMISSIONER.

KENNETH NIELSEN
COMMISSIONER.

FILED
AT OREGON M
SEP 30 1957
HARRY L. CHASE
COUNTY CLERK