

CLAIM OF BENEFICIAL USE


ALTERNATE REVIEW RESERVOIR

APPLICATION R-87811 PERMIT R-14991

SECTION 7, TOWNSHIP 38 S., RANGE 4W., W.M.

Jackson County, Oregon

RECEIVED
OCT 02 2023
OWRD

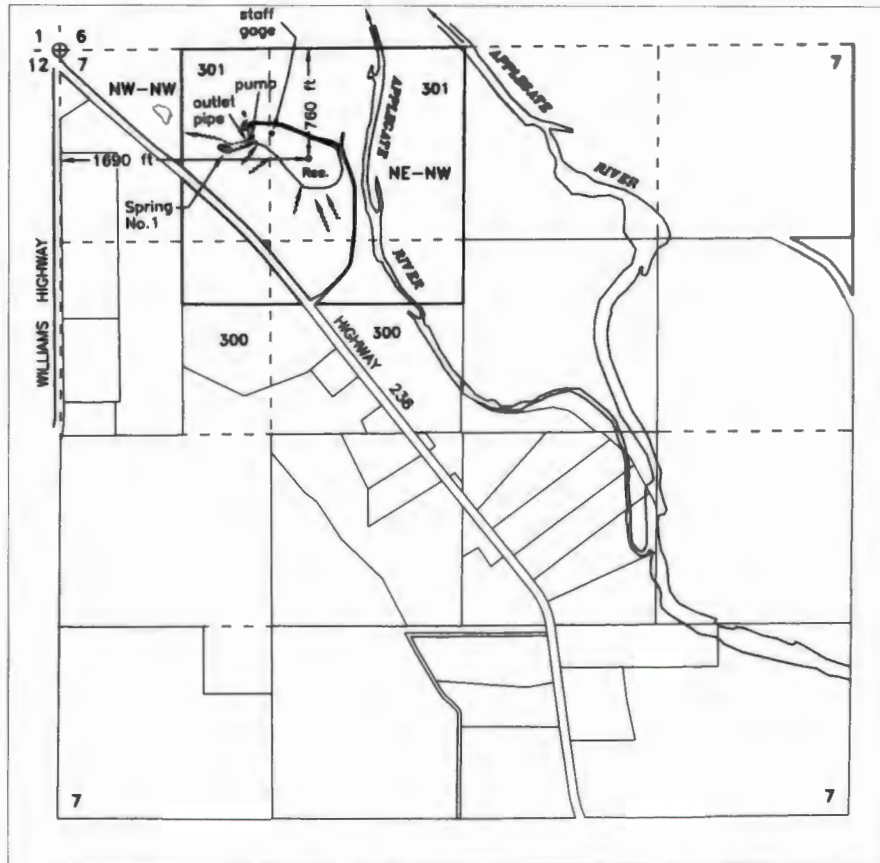

Center of Reservoir - 760 feet south & 1690 feet east from the NW corner of section 7



Blue Heron Reservoir (Multi-Purpose) 20 Acre-Feet
SOURCE - surface seepage, run-off, spring No.1 & springs within reservoir area



Runoff & surface seepage

PREPARED FOR:

JOHN C. HILL & WESLEY S. HILL
14850 HIGHWAY 238
GRANTS PASS, OR 97527



Scale
1 inch = 1320 feet

JORDAN ENGINEERING
460 JORDAN LANE
ROSEBURG, OREGON 97471
(541) 673-1931

Base map- Jackson Co. GIS over 5-19-23 Google Aerial photo. Final Proof Survey Map for Permit S-47468 used for control and location of Spring No. 1

This map is not intended to provide legal dimensions or locations of property ownership lines

Drawn
8/29/2023 n.e.d.