


R3W

16 | 15

22

15 | 14  
22 | 23

T15

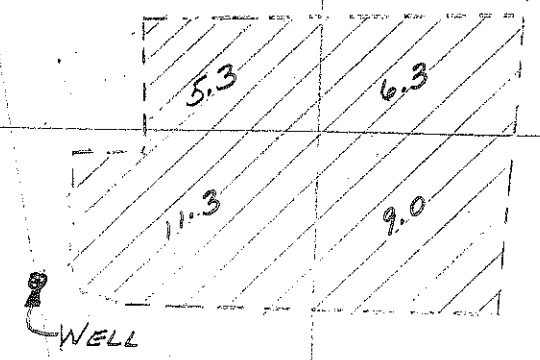

Rudolph P. Meyer  
T15 R3W  
SCALE 8"=1 mi

--- Irrigated - 20 Acres

Cancel  
6.3 & 9.0

GR 7953