


T. 13 S., R. 6 W., W. M.

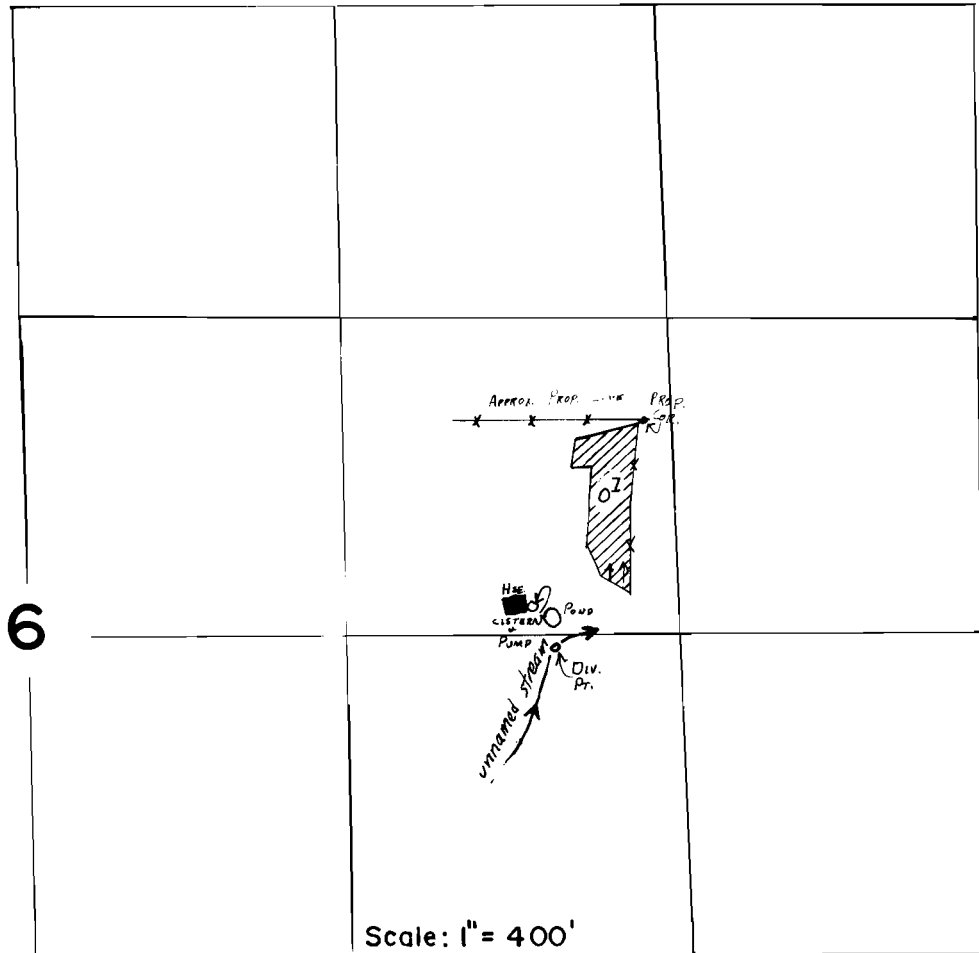

DIV. PT. LOC.: 30' S. & 1100' E. from the Center 1/4 Cor.  
Section 6

**FINAL PROOF SURVEY**  
UNDER

R-56397 R-6657  
Application No. ~~56398~~ Permit No. ~~42000~~...  
IN NAME OF

.....**MILTON EUGENE ROWLAND**.....

Surveyed **JUNE 14, 1983**, by **L. TOLL**.....