


ROBERT E. WHITE
RT 1, BOX 248A,
JEFFERSON, ORE.

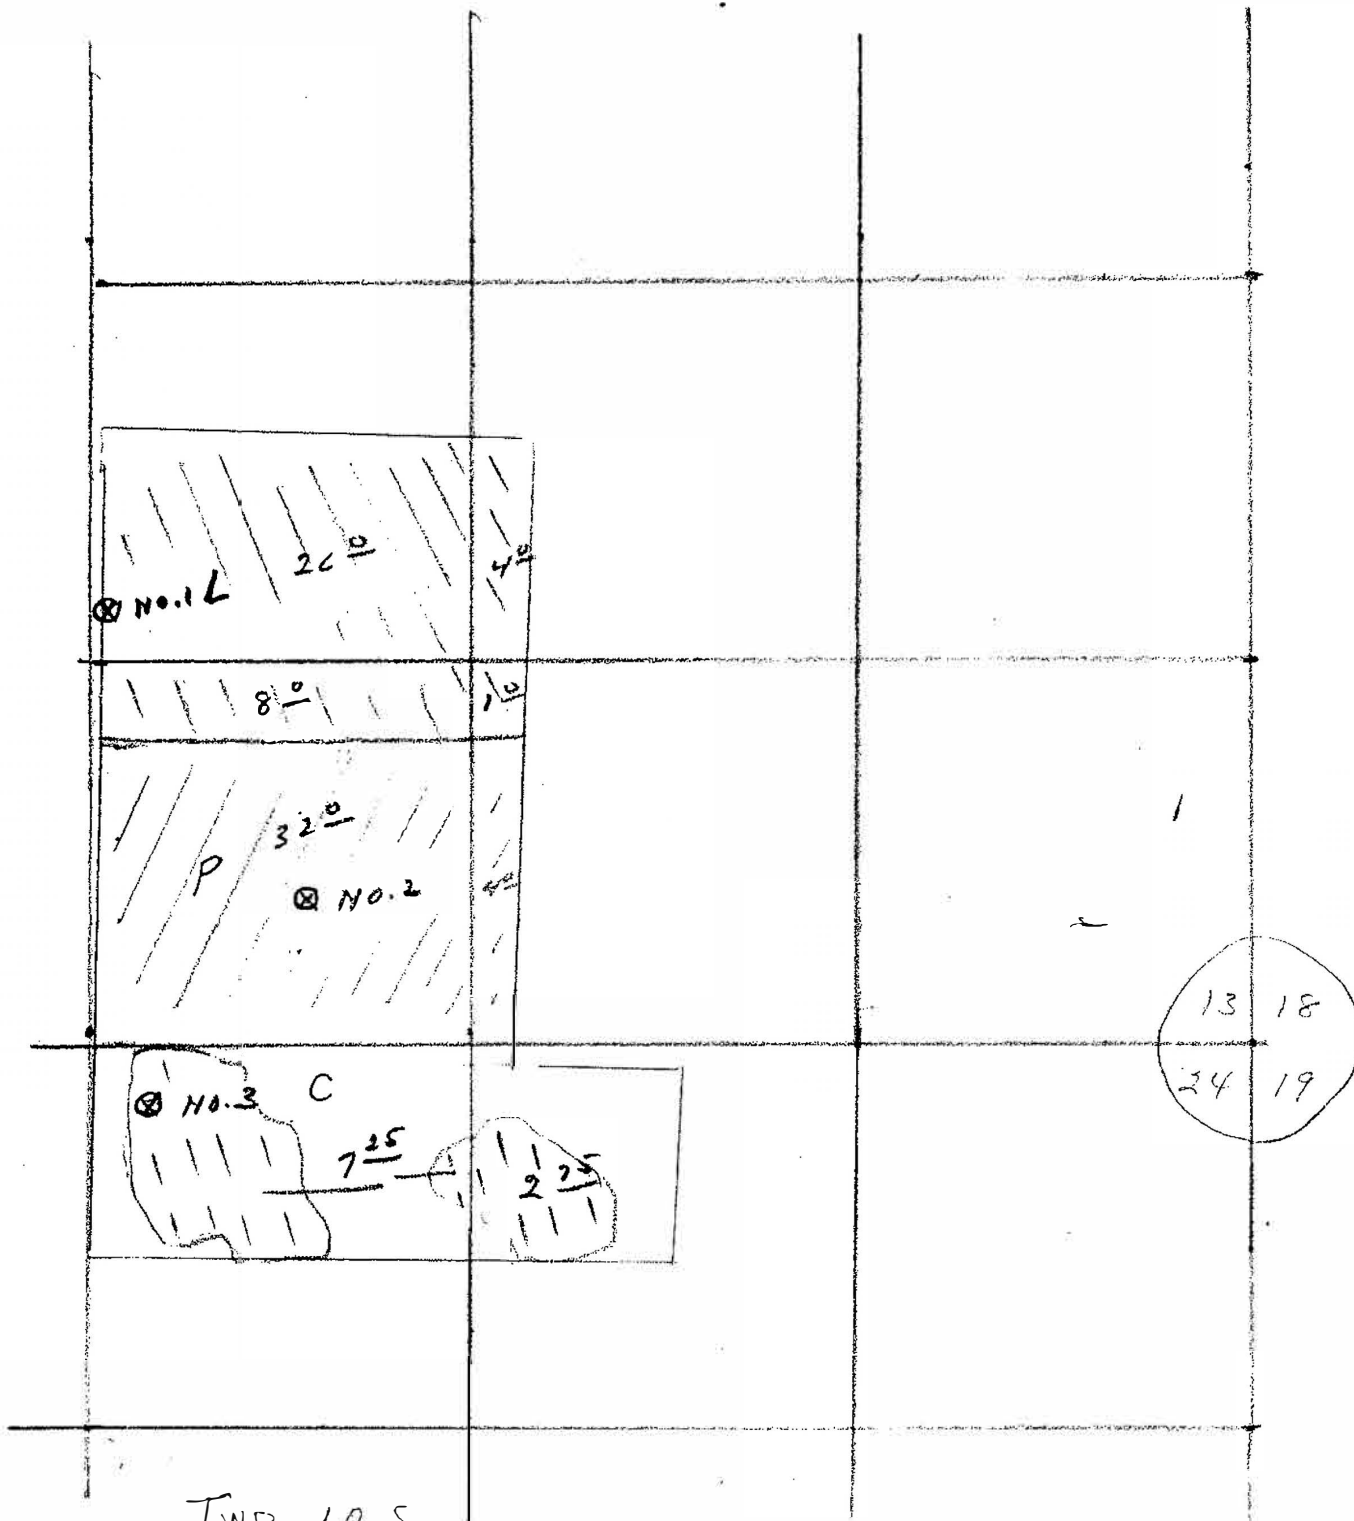

Twp 10 S

R9. E 11

Map 3D-122 + 2P-6

G-R-3749