


T. 13 S., R. 6 W., W. M.

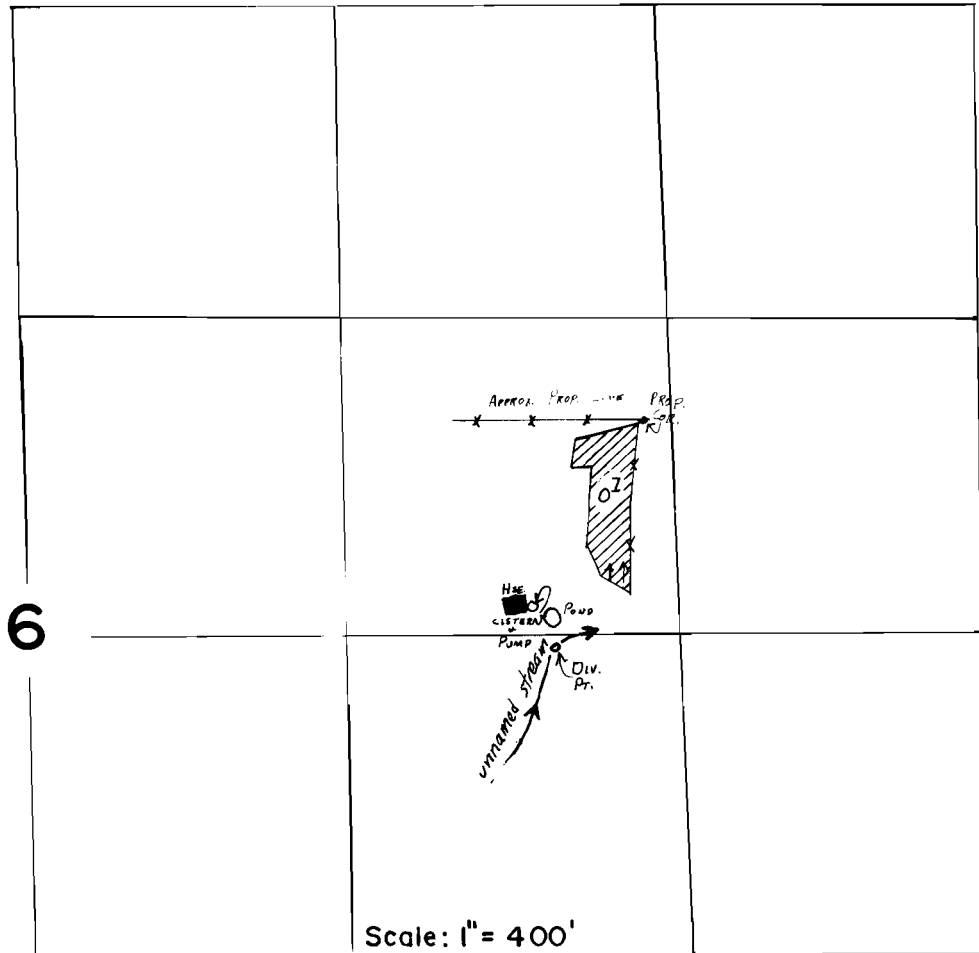

DIV. PT. LOC.: 30' S. & 1100' E. from the Center 1/4 Cor.
Section 6

FINAL PROOF SURVEY
UNDER

R-56397 R-6657
Application No. ~~56398~~ Permit No. ~~42000~~...
IN NAME OF

.....MILTON.....EUGENE.....ROWLAND.....

Surveyed JUNE 14, 1983, by ..L..TOLL.....