






# T.6S. R.1E. Sec. 16, 17, & 20, W.M.

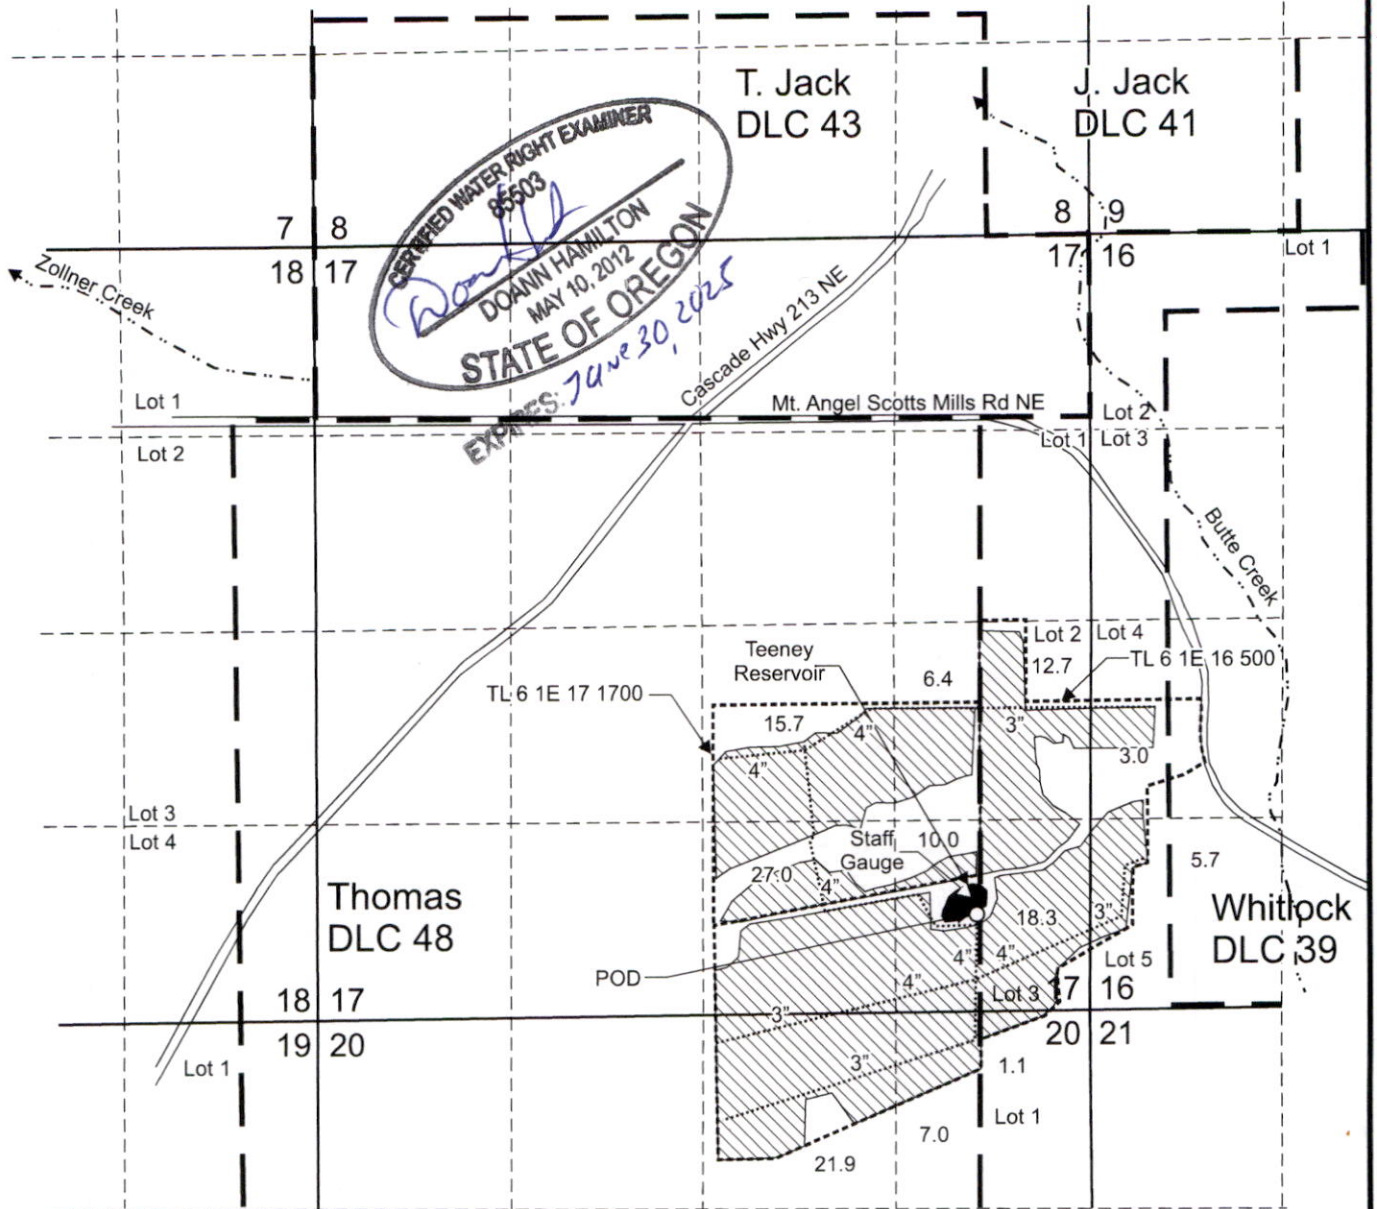

POD for Teeneey Reservoir is located 660 feet north and 775 feet west from the SE corner, Section 17.

 Area (128.8 Acres) irrigated under Application S-88755, Permit S-55209.

-  Tax lot boundary
-  Donor Land Claim boundary
-  Irrigation mainline

**RECEIVED**  
**OCT. 10 2023**  
**OWRD**



Scale: 1" = 1,320'



This map was prepared for the purpose of identifying the location of a water right only and is not intended to provide legal dimensions or location of property ownership lines.

**Claim of Beneficial Use Map**  
**Application S-88755, Permit S-55209**

Kraemer Farms (Teeneey)  
T.6S. R.1E. Sec. 16, 17, & 20, W.M.

Pacific Hydro-Geology Inc.

07/2023