


T14S, R35E, W.M.

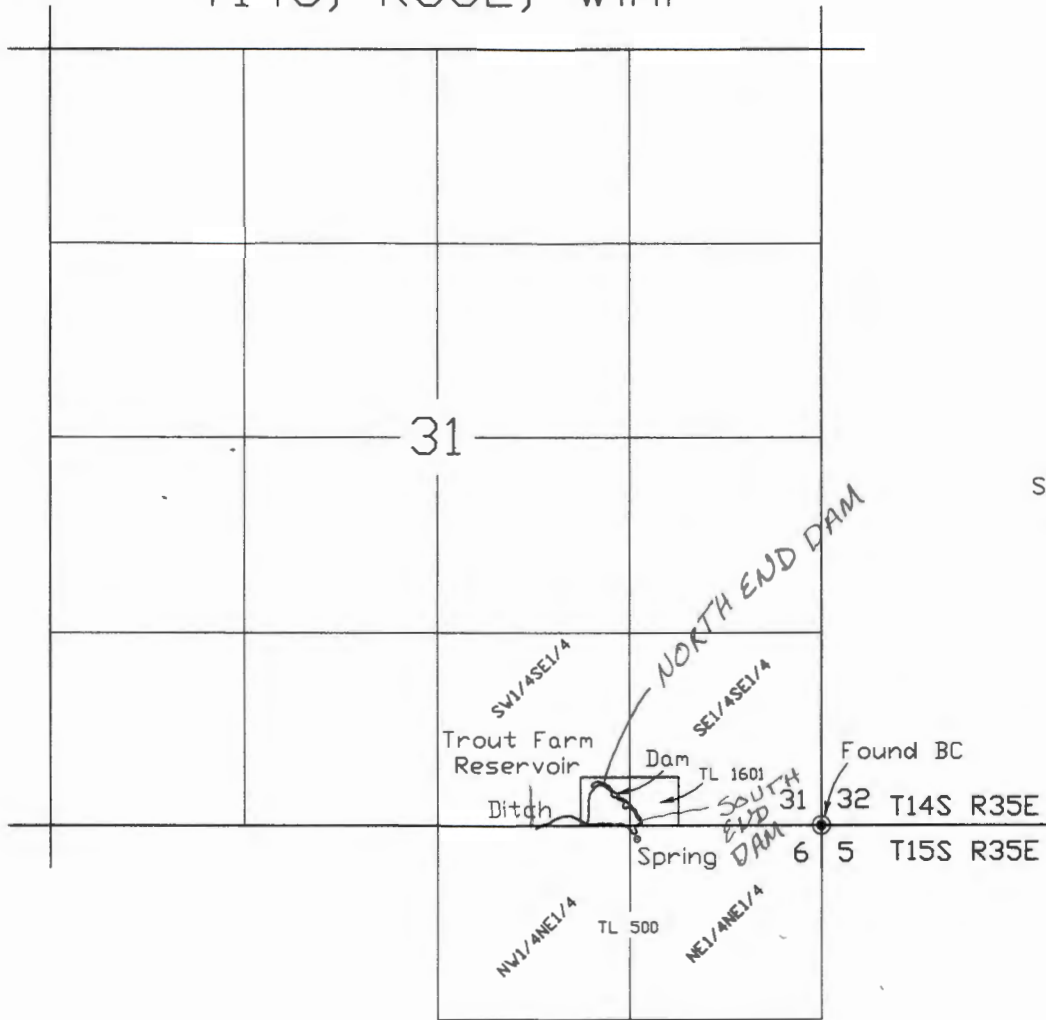

SCALE 1"=1320'



NOT TO SCALE

APPLICATION MAP FOR TROUT FARM RESERVOIR

June 23, 2023

Prepared for
USDA Forest Service
John Day

OWRD

RECEIVED
OCT 17 2023

RECEIVED

AUG 24 2023

OWRD

NOTE: The preparation of this map was for the purpose of identifying the location of the proposed water right and has no intent to provide dimensions or location of property ownership lines.

