


Claim of Beneficial Use - Arnzen

Application G-18763, Permit G-18275

Township 6S, Range 2W, W.M.



This map is not intended to provide legal dimensions or locations of property ownership lines.

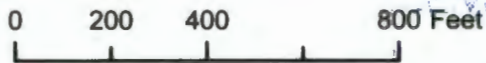

Legend

-  POU
-  Mainline
-  Taxlot



EXPIRES: 12-31-2024

RECEIVED

OCT 16 2023