


Township 40S, Range 2E.

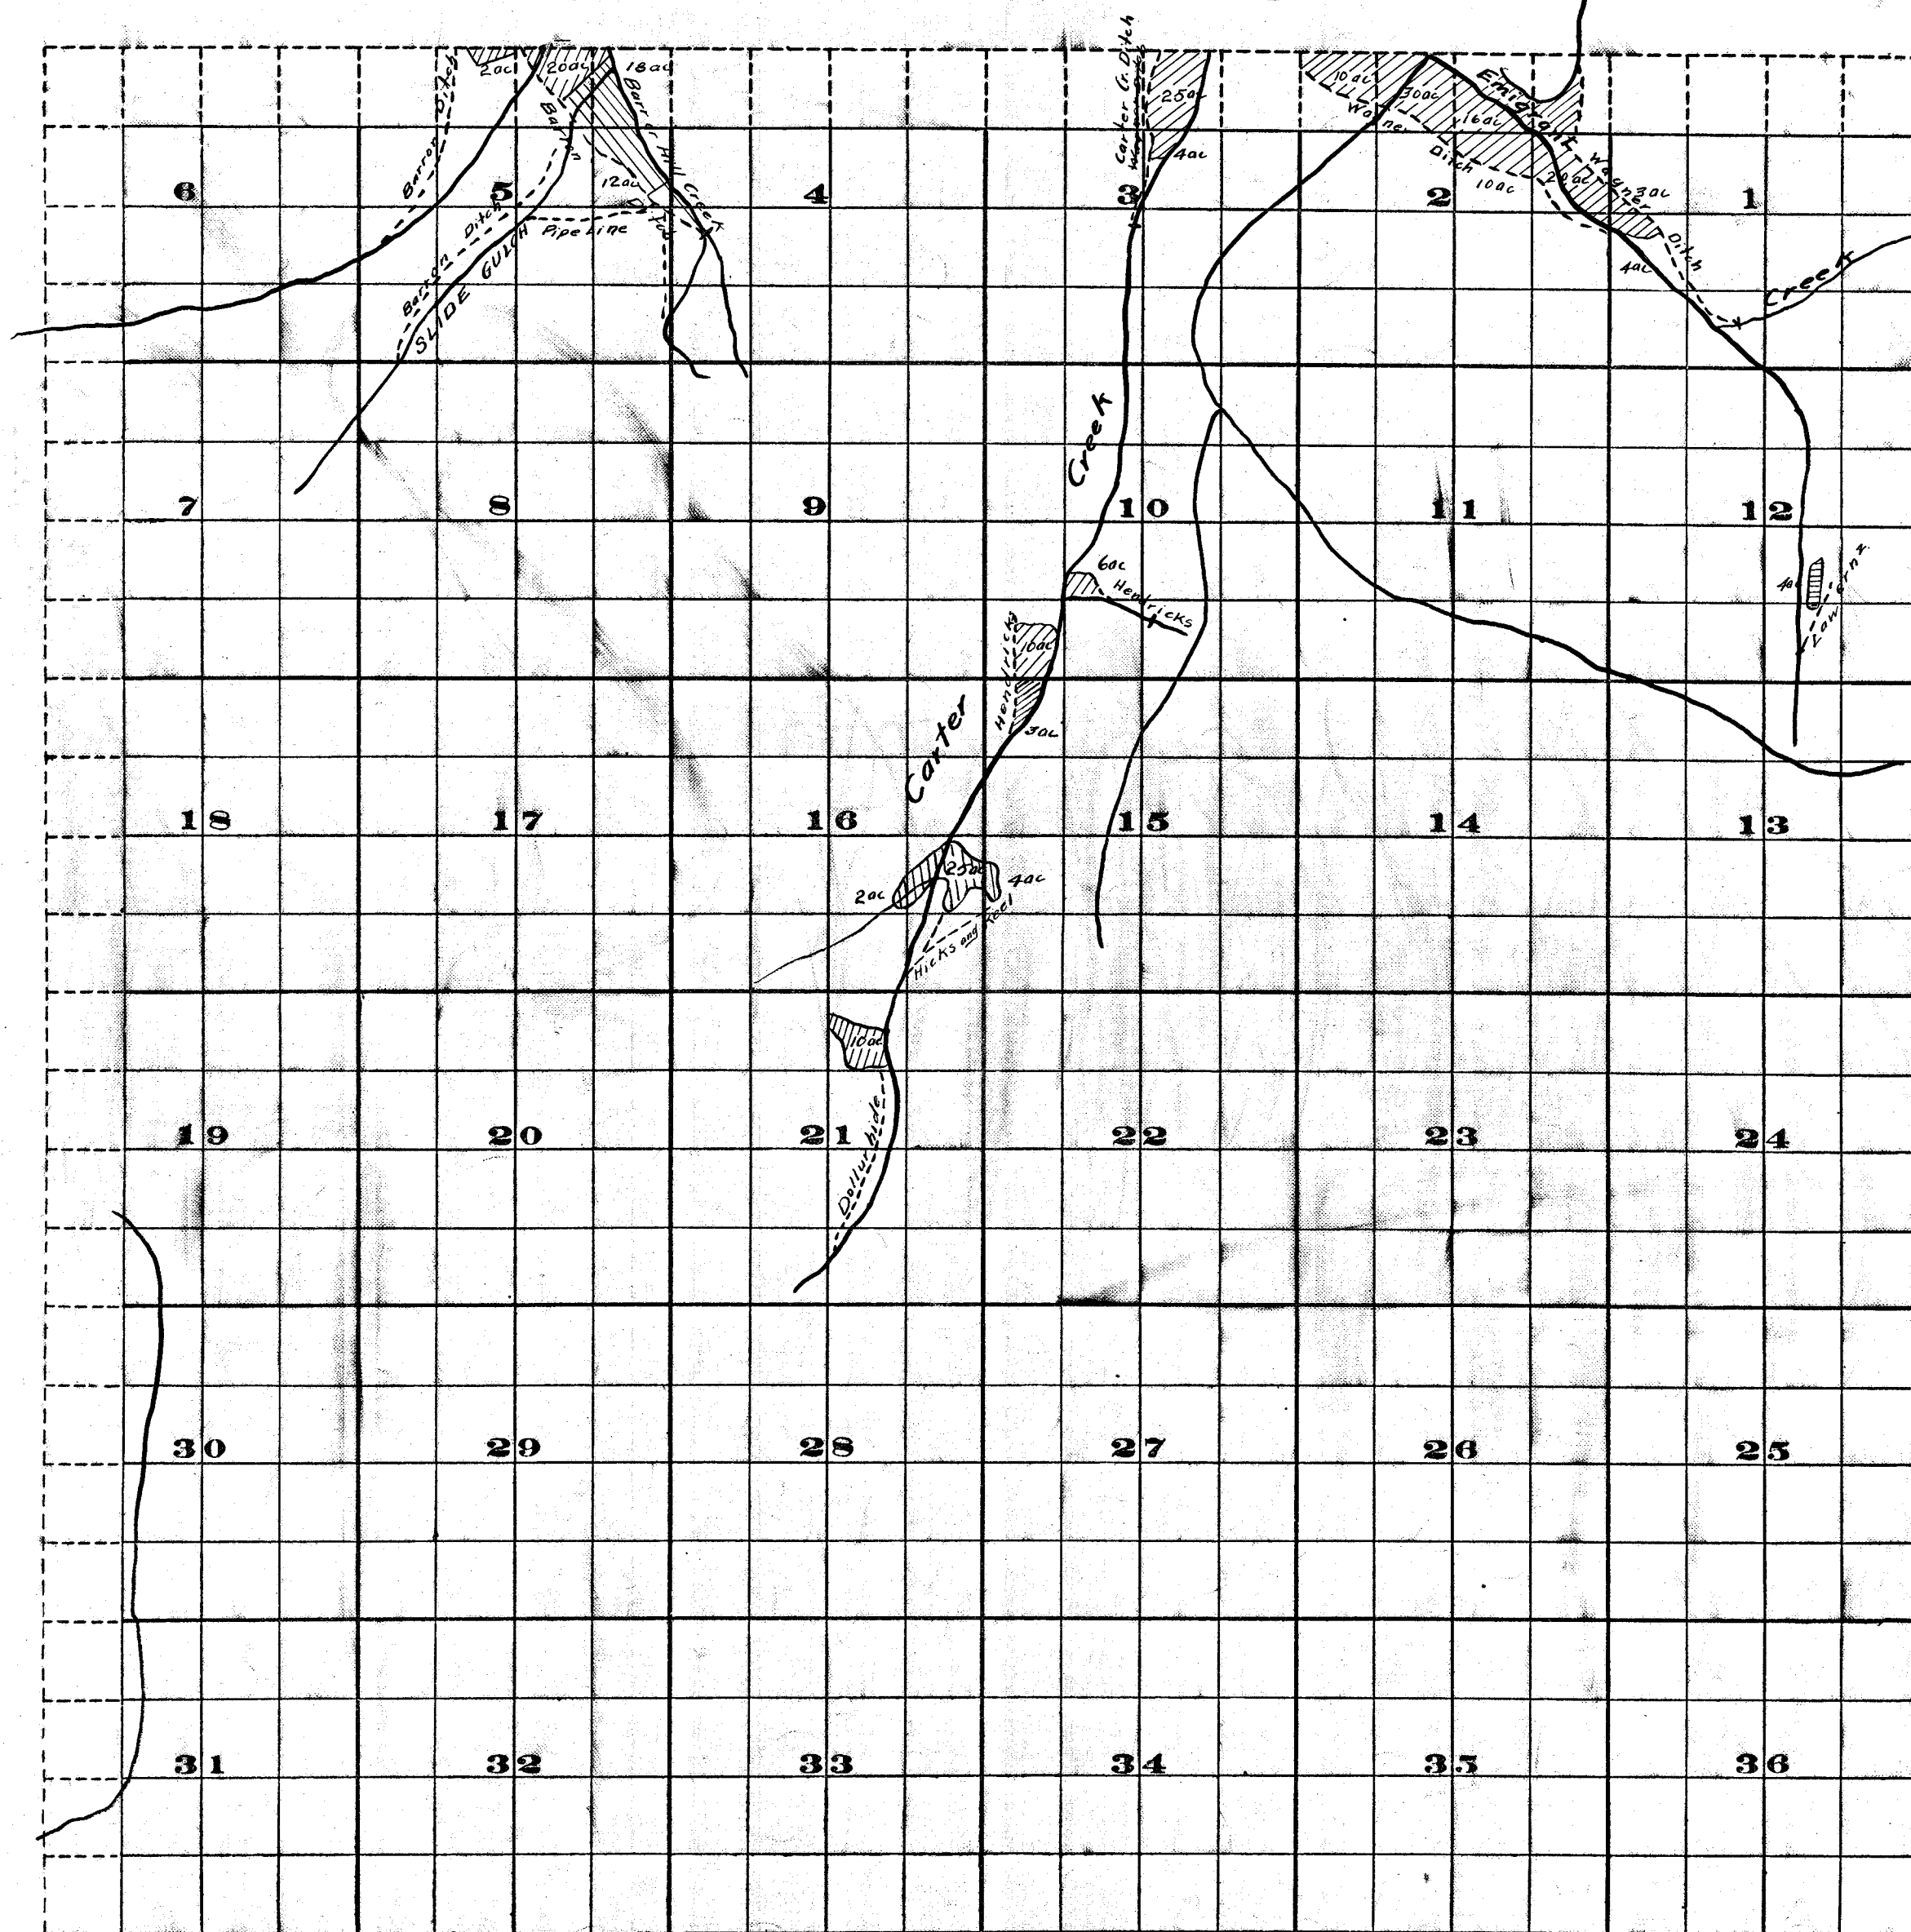

Survey by H.K. Donnelly May 1910
 Scale of Feet.
 0 1 2 3

FROM OFFICE OF THE STATE ENGINEER, SALEM, OREGON

Adjudication
 Rogue River and Tributaries
 John H. Lewis State Engr.

Examined Sept. 18, 1911