



Township 39S, Range 1W.

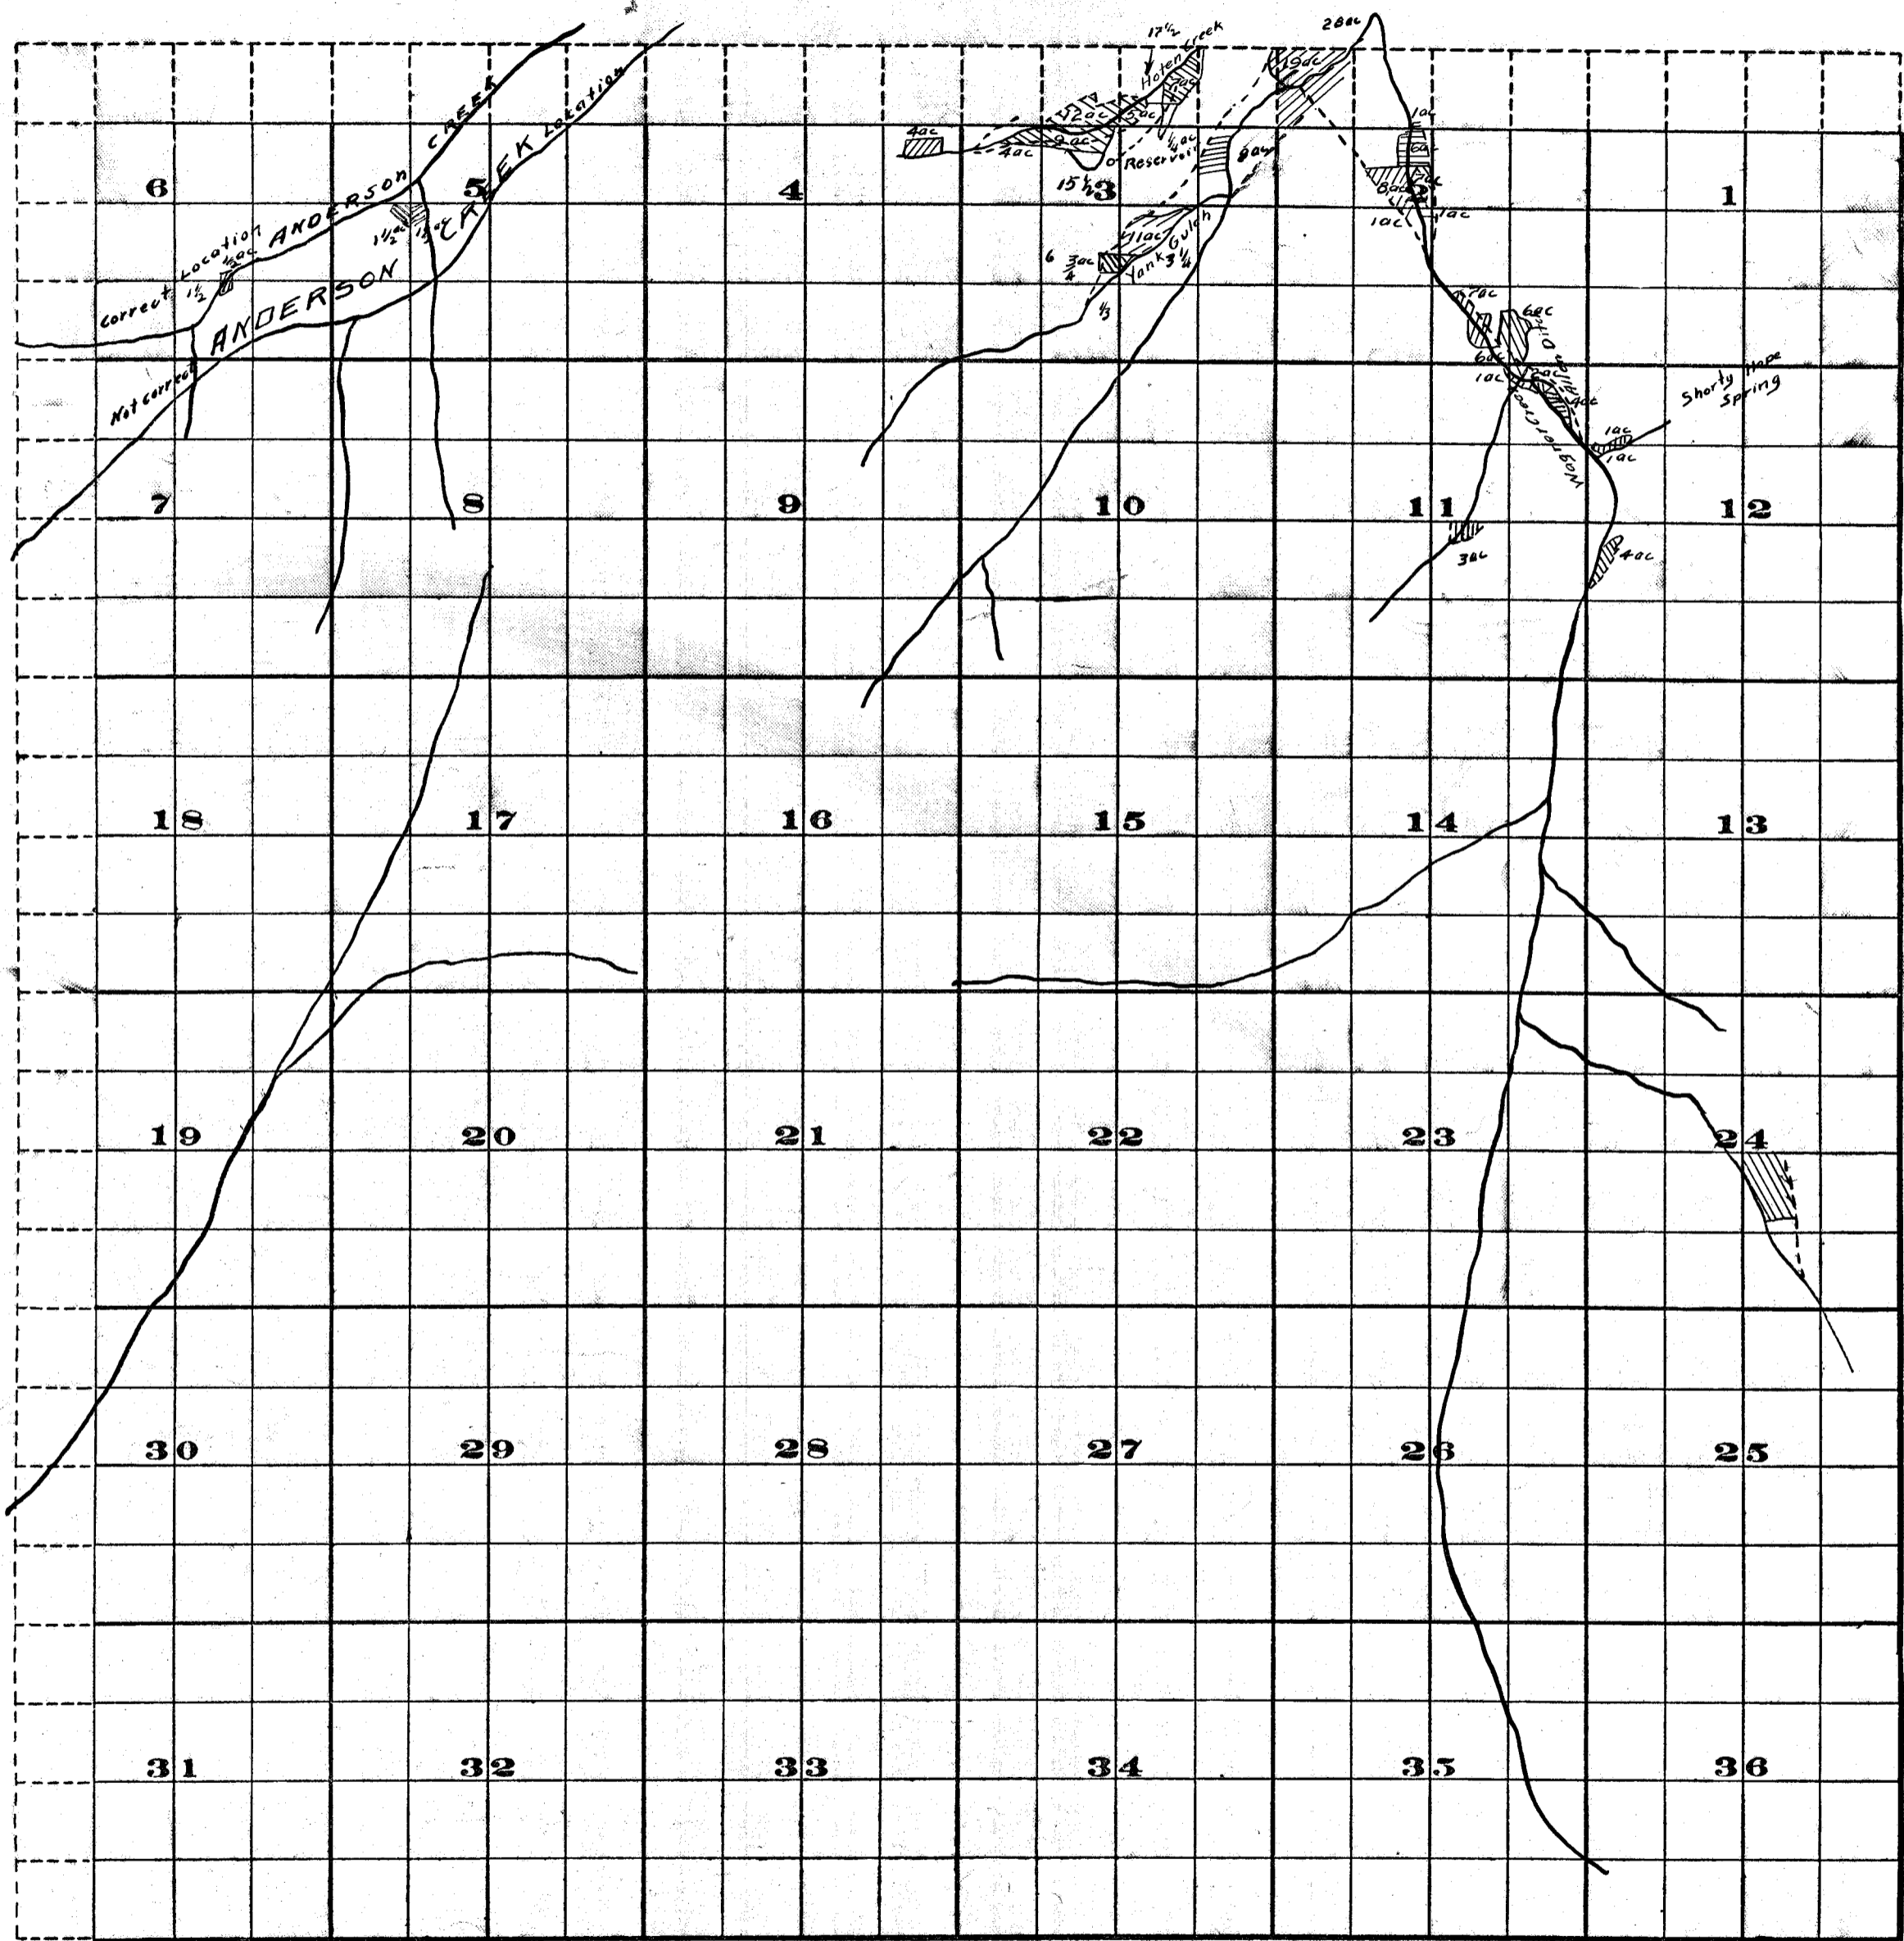

Survey by H.D. Farmer July 1911

FROM OFFICE OF THE STATE ENGINEER, SALEM, OREGON

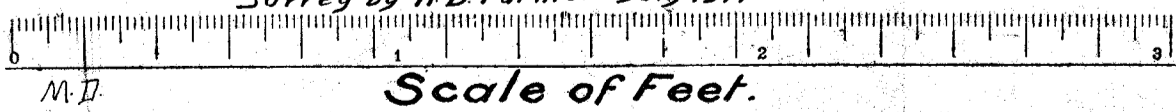

Adjudication

Rogue River and Tributaries.

John H. Lewis State Engr

Examined Sept. 18, 1911