
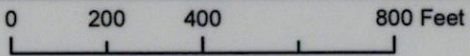


Claim of Beneficial Use - Sonnen - T-12855

Township 4S, Range 2W, W.M.

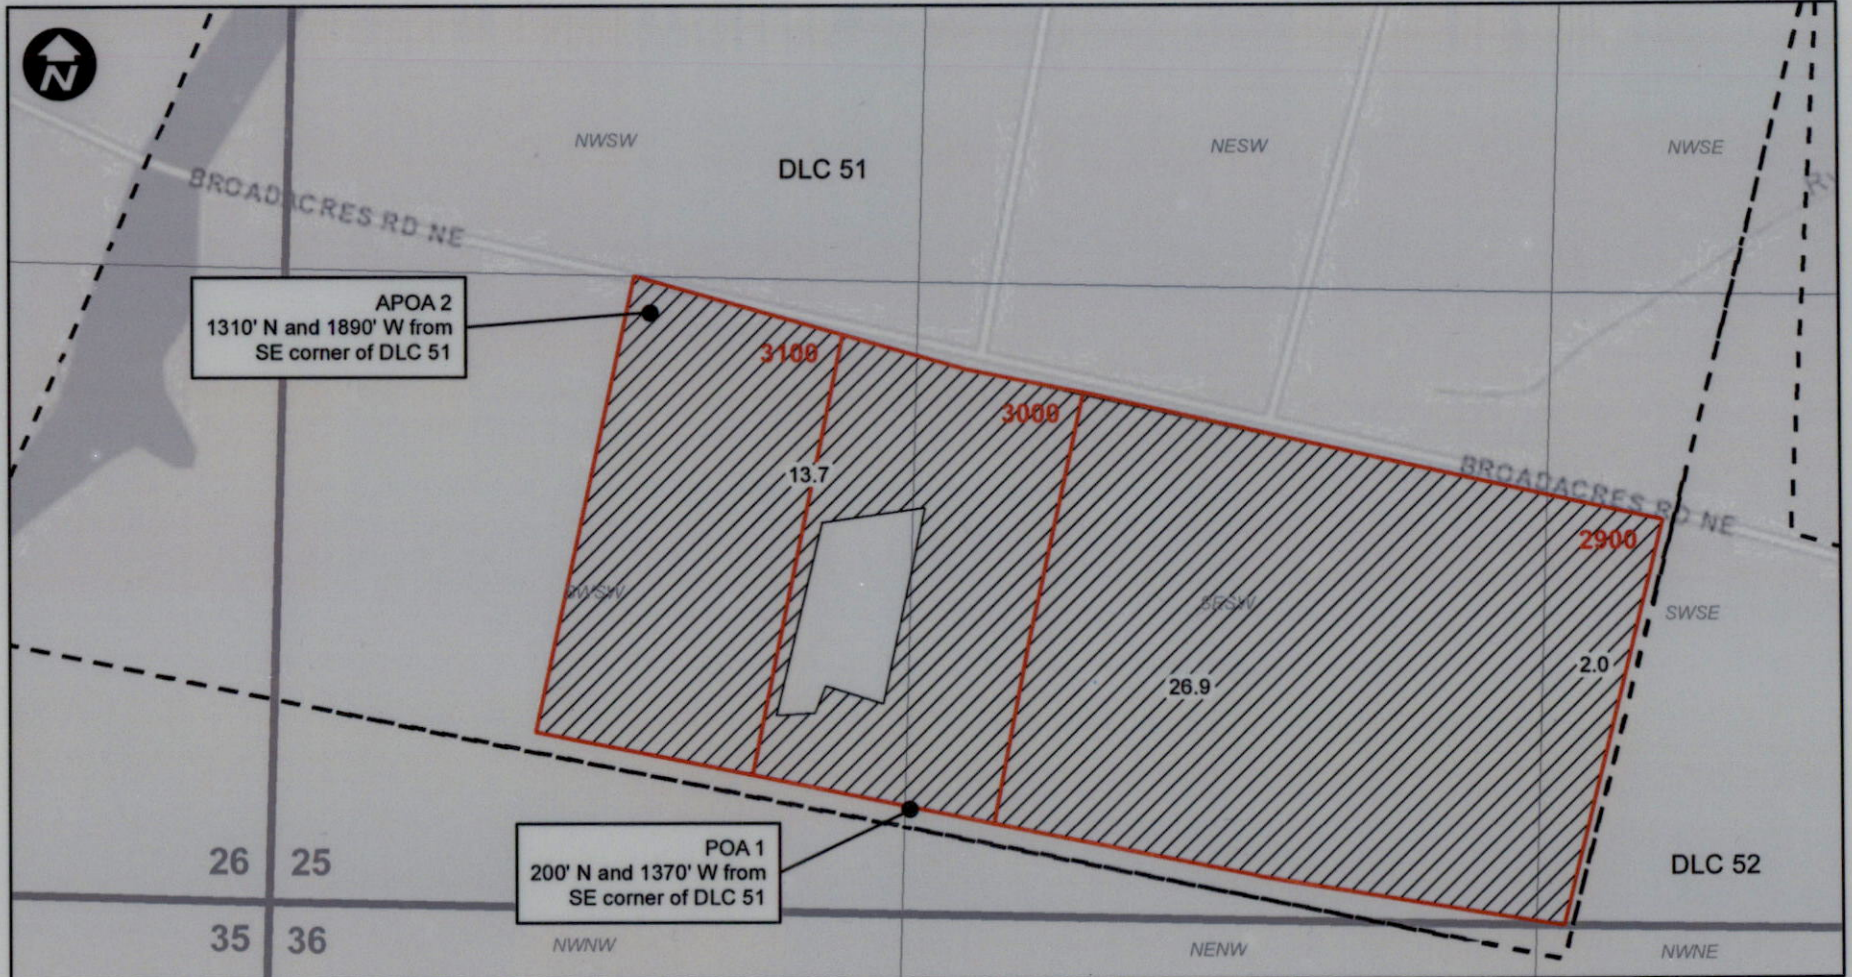


This map is not intended to provide legal dimensions or locations of property ownership lines.

Legend

- Irrigation POI
- Taxlot
- DLC

RECEIVED  
OCT 31 2023  
OWRD

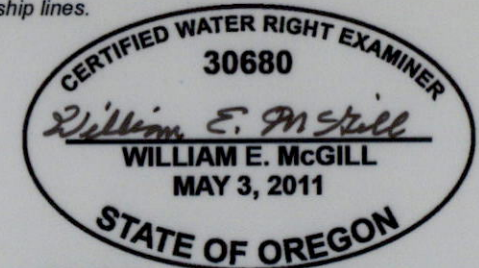

EXPIRES: 12-31-24