

15155 Dunn Forest Road

T10S R5W S6 TL 213

RECEIVED BY

APR '06 2017

SALEM, OR

RECEIVED


OCT 10 2023

OWRD

RECEIVED
OCT 30 2023
OWRD
SALEM, OREGON

CATCHMENT POND 1

NORTH ↑

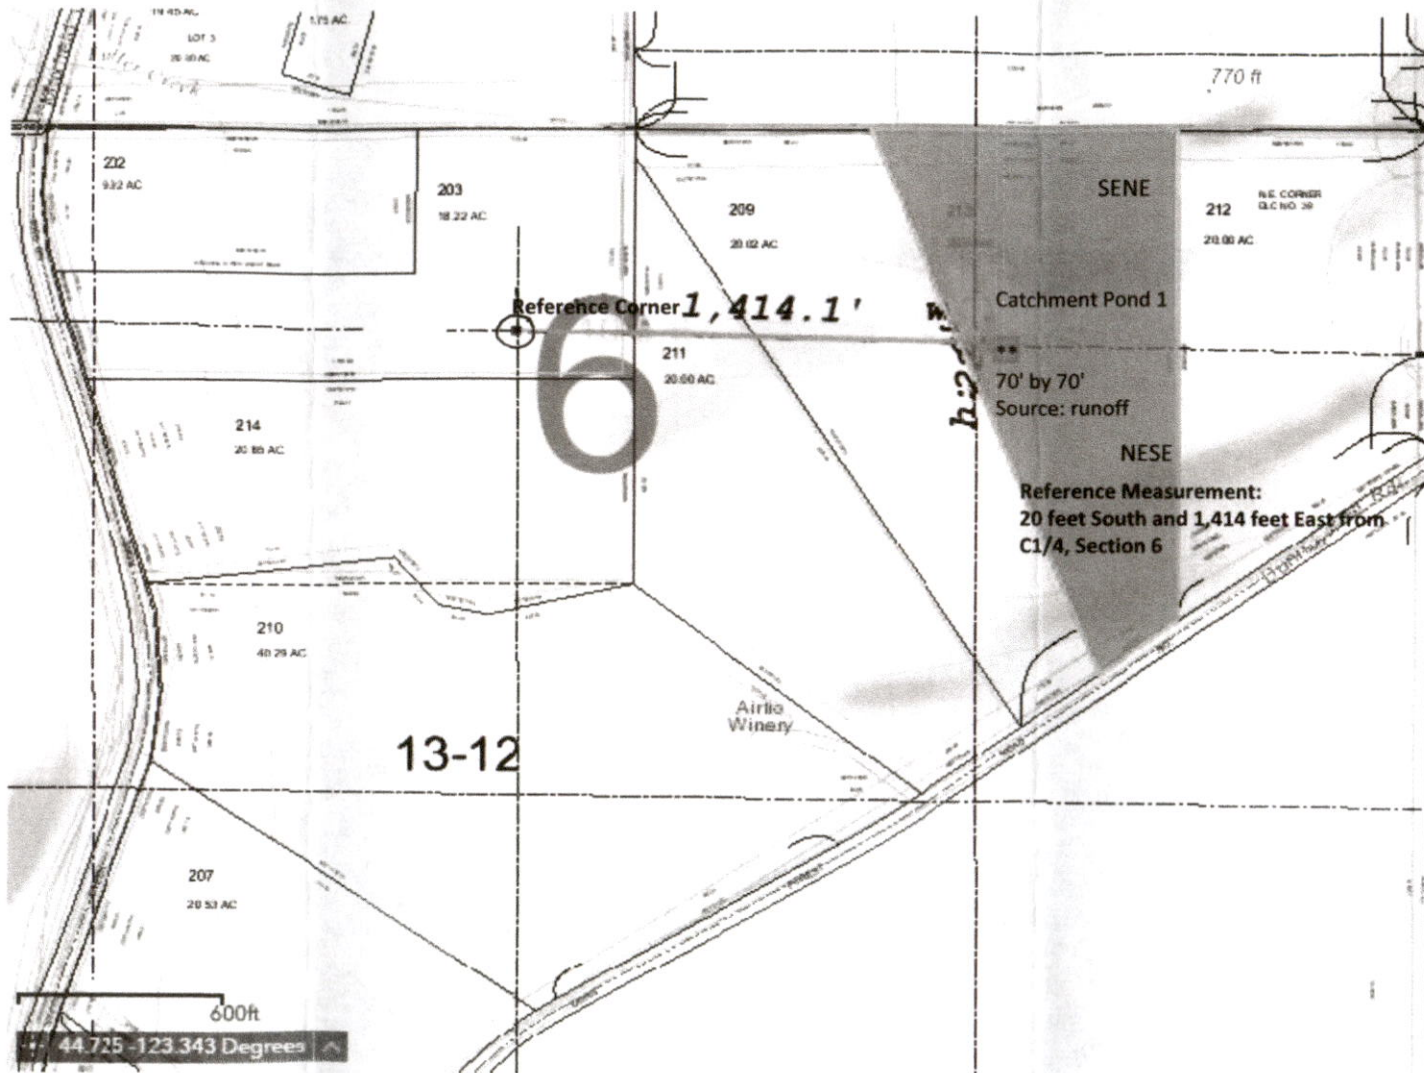

600ft
44.725 - 123.343 Degrees

1" = 600 Ft.

2-88387

13-12