


FINAL PROOF MAP R-12020
SE1/4SW1/4 SECTION 28, T.34S., R.6W., W.M.
JOSEPHINE COUNTY, OREGON
FOR
CALVIN D. AND PAMELA M. MORRIS
6155 TUNNEL LOOP ROAD
GRANTS PASS, OREGON 97526

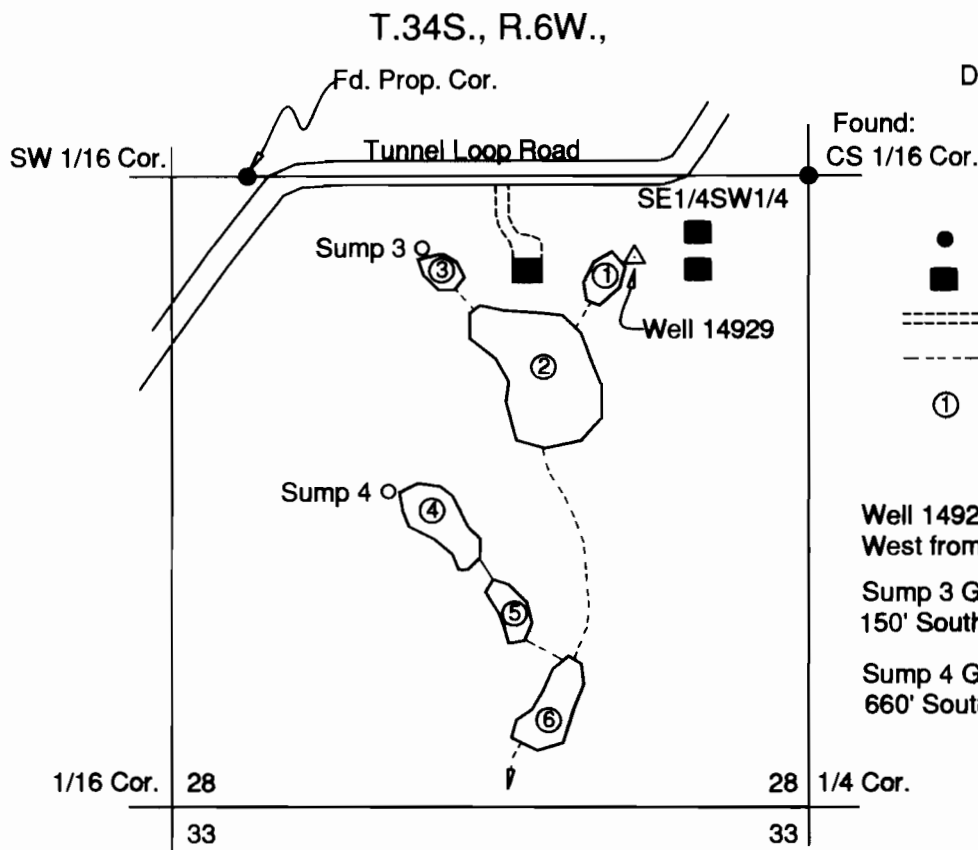

Scale: 1"=400'
Date: October 3, 2005
August 9, 2006



LEGEND

- Found Survey Monument
- Denotes Building
- Denotes Driveway
- - - - - Denotes Drainage
- ① Denotes Reservoir Number
Refer to Permit R-12020


Well 14929 is situated 170' South & 360' West from CS 1/16 Cor. (NE Prop Cor.)

Sump 3 Ground Water Source is located: 150' South & 800' West from CS 1/16 Cor.

Sump 4 Ground Water Source is located: 660' South & 870' West from CS 1/16 Cor.

**R-12020
AREA SUBMERGED/CAPACITY**

- | | |
|---|---|
| <p>① Reservoir 1
Area = 0.30 acres
Volume = 0.90 acre ft.</p> <p>② Reservoir 2
Area = 0.63 acres
Volume = 5.67 acre ft.</p> <p>③ Reservoir 3
(Ground Water Source)
Area = 0.03 acres
Volume = 0.08 acre ft.</p> | <p>④ Reservoir 4
(Ground Water Source)
Area = 0.33 acres
Volume = 2.00 acre ft.</p> <p>⑤ Reservoir 5
Area = 0.05 acres
Volume = 0.23 acre ft.</p> <p>⑥ Reservoir 6
Area = 0.21 acres
Volume = 1.47 acre ft.</p> |
|---|---|

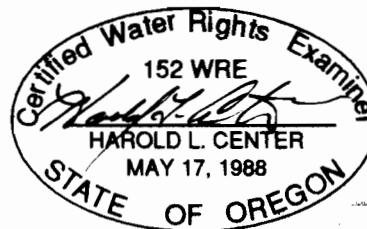

HAROLD L. CENTER
2604 David Lane
Medford, OR. 97504
Phone 541-535-6108
Oregon Certificate No. 152
Certificate Renewal Date: 12/31/2007

RECEIVED

DEC 13 2006

WATER RESOURCES DEPT
SALEM, OREGON

This map was prepared for the purpose of identifying the location of a water right only and is not intended to provide legal dimensions or location of property ownership.