


Claim of Beneficial Use
Permit S-54783, Application S-49201
 A Water Right held by Pacific City Joint Water-Sanitary Authority
 Tillamook County

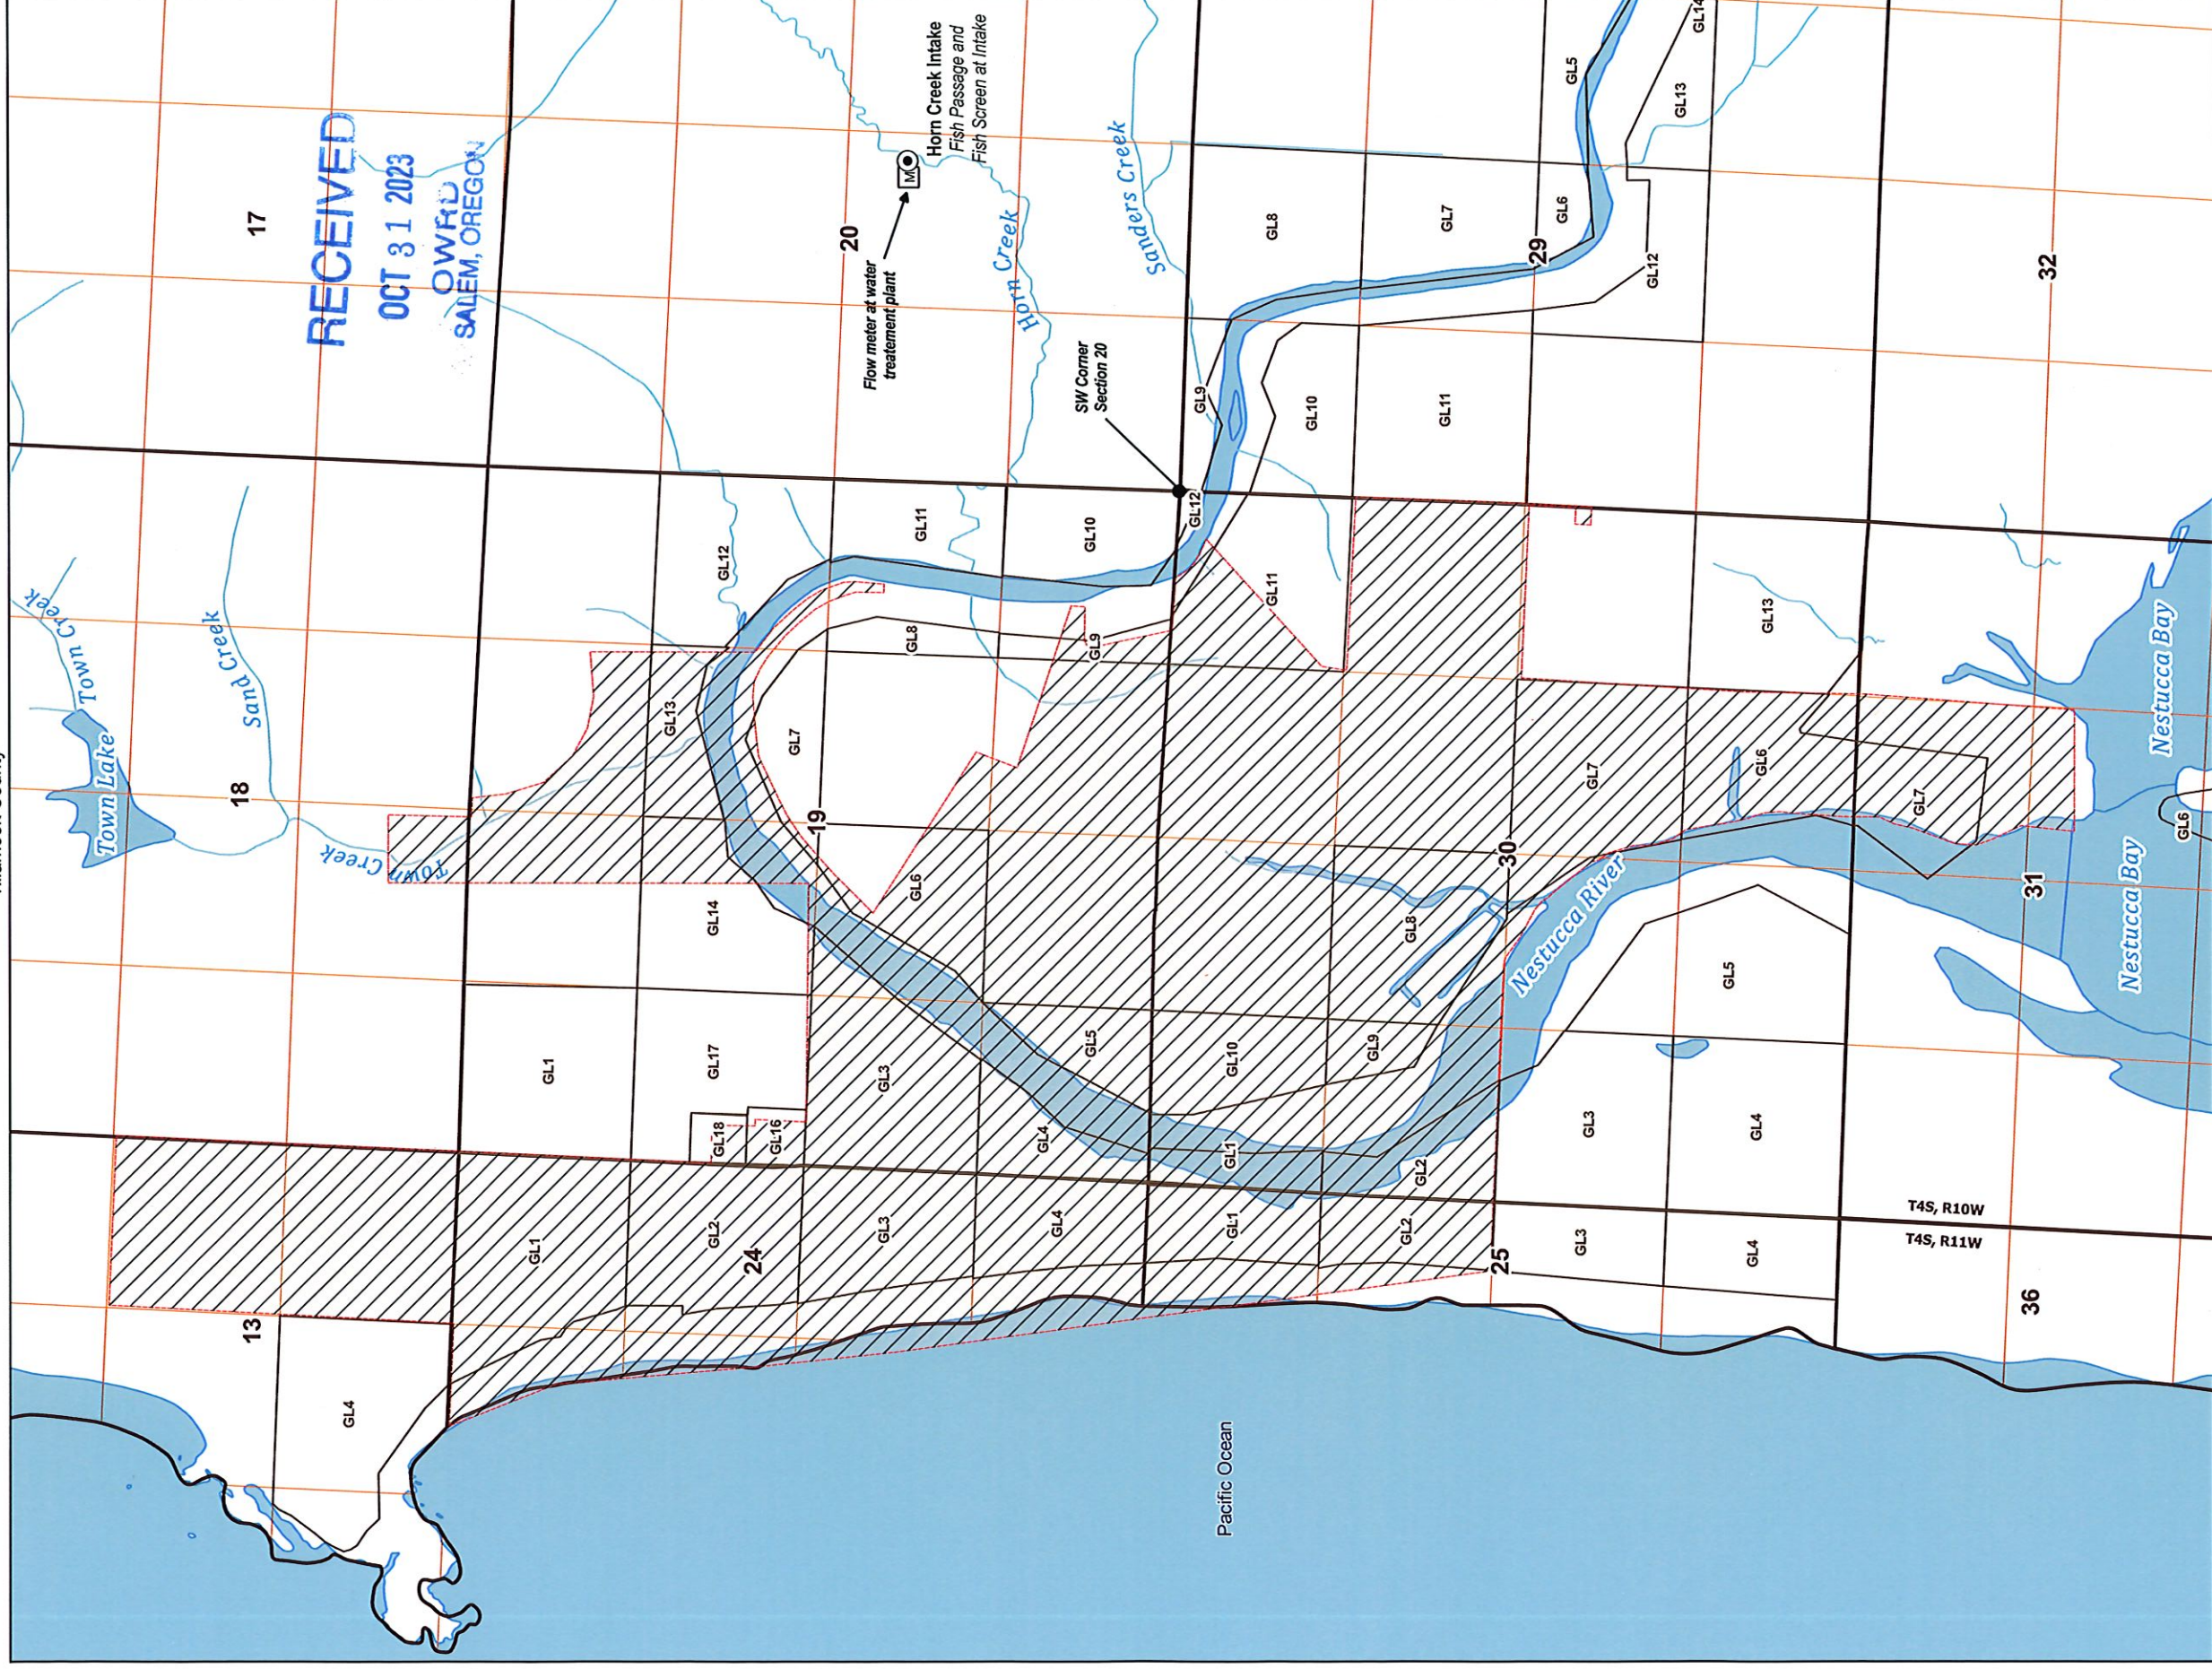

Legend


- POD - Horn Creek Intake
- ▨ Service Area Boundary (POU)
- Government Lots
- PLS Sections
- PLS QQ Sections
- Regional Waterbodies

POD Location Description

Horn Creek intake
 Located 2,200 feet North and 2,450 feet East from the SW corner
 of Section 20, Township 4 South, Range 10 West (W.M)

Map Information

Date: 7/11/2023
 Data Sources: BLM, OWRD, USGS, PCNWSA
 Disclaimer: This map is not intended to provide legal dimensions
 or property ownership lines.

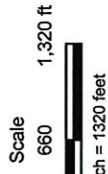

RENEWS: 12.31.2024

