
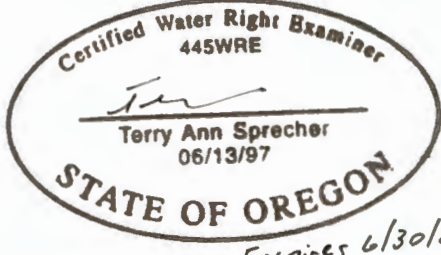


CLAIM OF BENEFICIAL USE MAP

TAX LOT 700

Located in SW-NW OF  
Section 22, T.6N., R.35E., W.M.  
UMATILLA COUNTY, OREGON

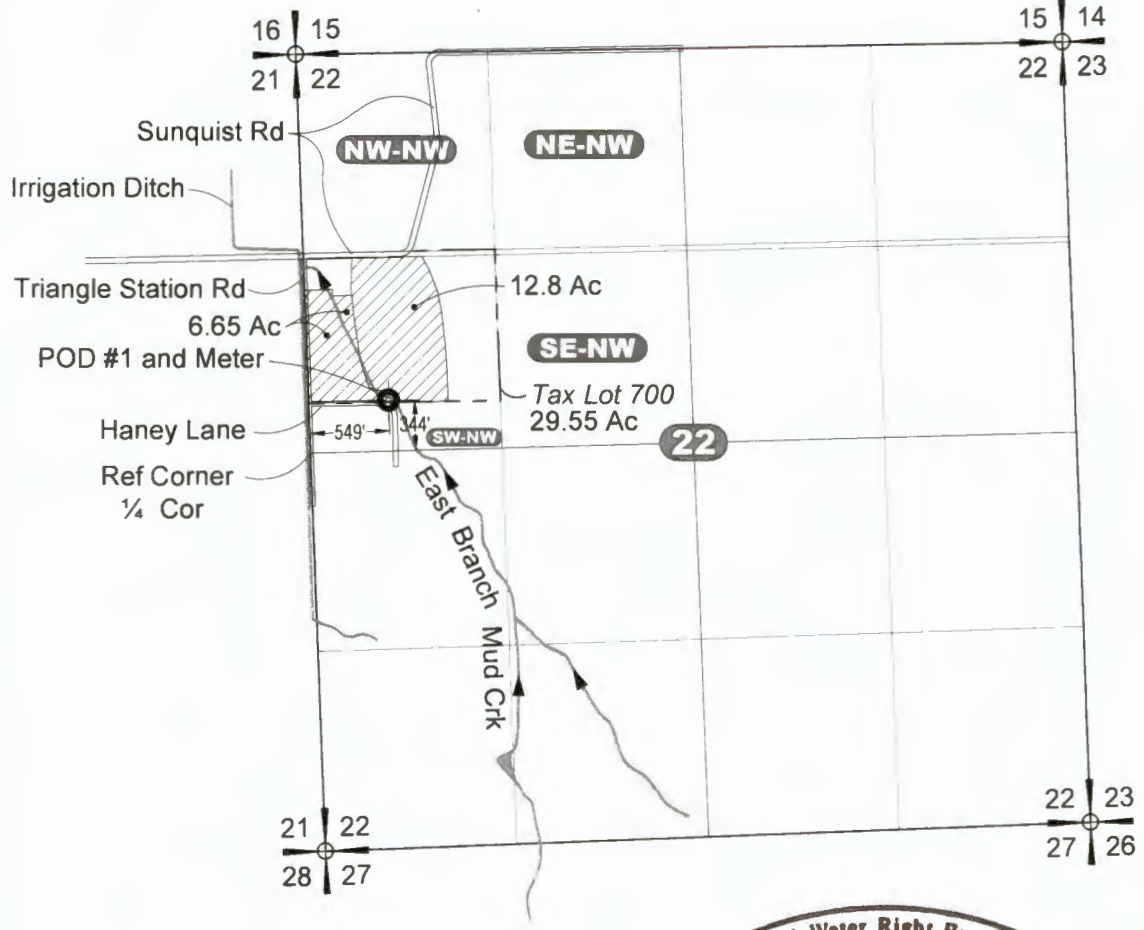

RECEIVED  
NOV 06 2023  
OWRD


Expires 6/30/2024

LEGEND

AUTHORIZED PLACE OF USE  
X.XX Ac

NOTE

THIS MAP WAS PREPARED FOR THE PURPOSE OF IDENTIFYING THE LOCATION OF WATER RIGHTS ONLY AND IS NOT INTENDED TO PROVIDE LEGAL DIMENSIONS OR LOCATIONS OF PROPERTY OWNERSHIP LINES.

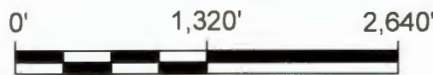

SCALE: 1" = 1,320'



REFERENCE NOTES

Map features supplied by Umatilla County Tax Map 6N 35 22B, dated 03/09/17.

Claim of Beneficial Use Map for T-13526  
Tax Lot 700, Tax Map: 6N 35 22B  
Milton-Freewater, Oregon, 97862

CREATED BY: TAS  
DRAWN BY: SJS

soil  
service water  
Sprecher group  
2445 NE Division St., Suite 300  
Bend, Oregon 97703  
SG PROJECT 4339  
AUGUST 2023