

ArcGIS Web Map

Township 10S
 Range 02W
 Section 28
 Quarter Quarter NE/NE
 Tax Lot# 102



dam

Pond#2
 44.67859,-122.92820

1000 feet W and
 200 feet S
 from corner 10S02W 400300
 Book#1 Page#182 Point 400,300

← CORNER
 102502W
 400300
 Book 1
 PAGE# 182
 POINT 400,300
 27
 1000

RECEIVED
 OCT 23 2023
 OWRD

Pond#1
 44.67705,-112.92879

dam

1100 feet W and 1400 feet S
 from corner 10S02W 400300
 Book #1 PAGE# 182 POINT 400,300

Crabtree Creek

Diversion Point
 44.67574,-112.92879


1000 feet west and 2300 feet S
 from corner 10S02W 400300
 Book #1 PAGE# 182 POINT 400,300

RECEIVED
 NOV 06 2023
 OWRD

9/15/2023, 11:15:24 AM

- Townships
- County Boundary
- Surveys
- Section Corners
- Cities
- Highways
- Roads
- Sections
- Tax Lots

1:2,257

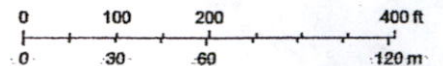

Linn County GIS, County of Linn, Bureau of Land Management,
 State of Oregon, State of Oregon DOT, State of Oregon GEO, Esri
 Canada, Esri, HERE, Garmin, INCREMENT P, USGS, METI/NASA,
 EPA, USDA