


# T.4S. R.4W. Section 36 and T.5S. R.4W. Section 1, W.M.

RECEIVED

NOV 13 2023

OWRD

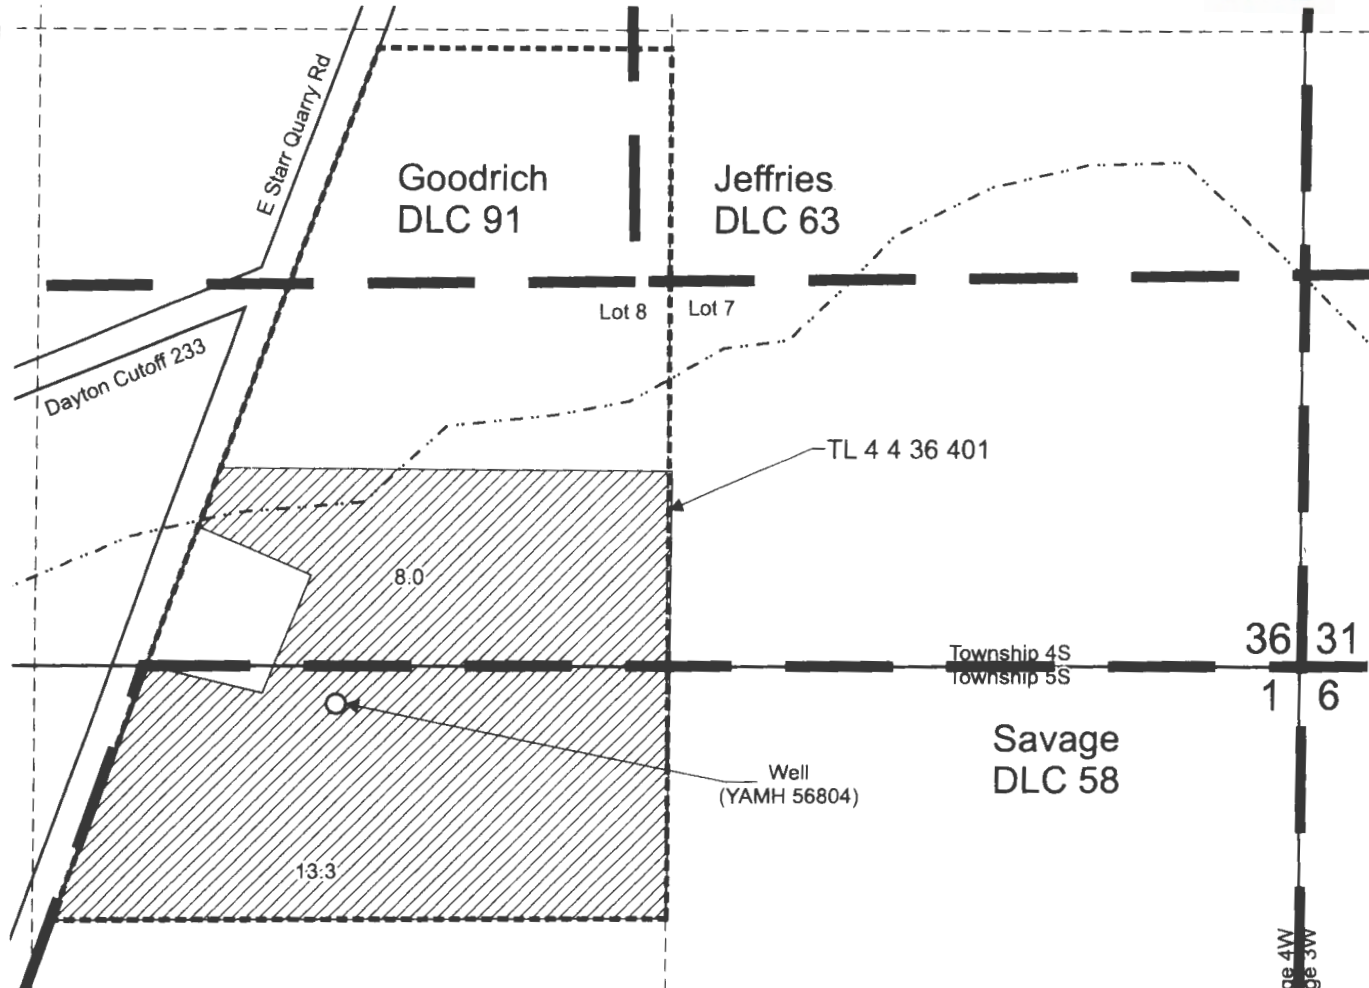

Well (YAMH 56804) is located 75 feet south and 1,995 feet west from the NE corner, Section 1.


Area (21.3 Acres) irrigated under T-11857, formerly Certificate 28281, priority date: 2-27-1956.

Tax lot boundary

Donation Land Claim boundary

CERTIFIED WATER RIGHT EXAMINER  
85503  
*Doann Hamilton*  
DOANN HAMILTON  
MAY 10, 2012  
STATE OF OREGON  
EXPIRES: July 30 2025

Scale: 1" = 400'

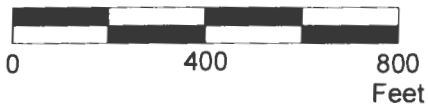

This map was prepared for the purpose of identifying the location of a water right only and is not intended to provide legal dimensions or location of property ownership lines.

Claim of Beneficial Use Map  
T-11857, formerly Certificate 28281

Kit Johnston  
T.4S. R.4W. Section 36  
T.5S. R.4W. Section 1, W.M.

Pacific Hydro-Geology Inc.

10/2023

JohnstonT-11857COBUMap.cdr