


TOWNSHIP 1 SOUTH RANGE 43 EAST

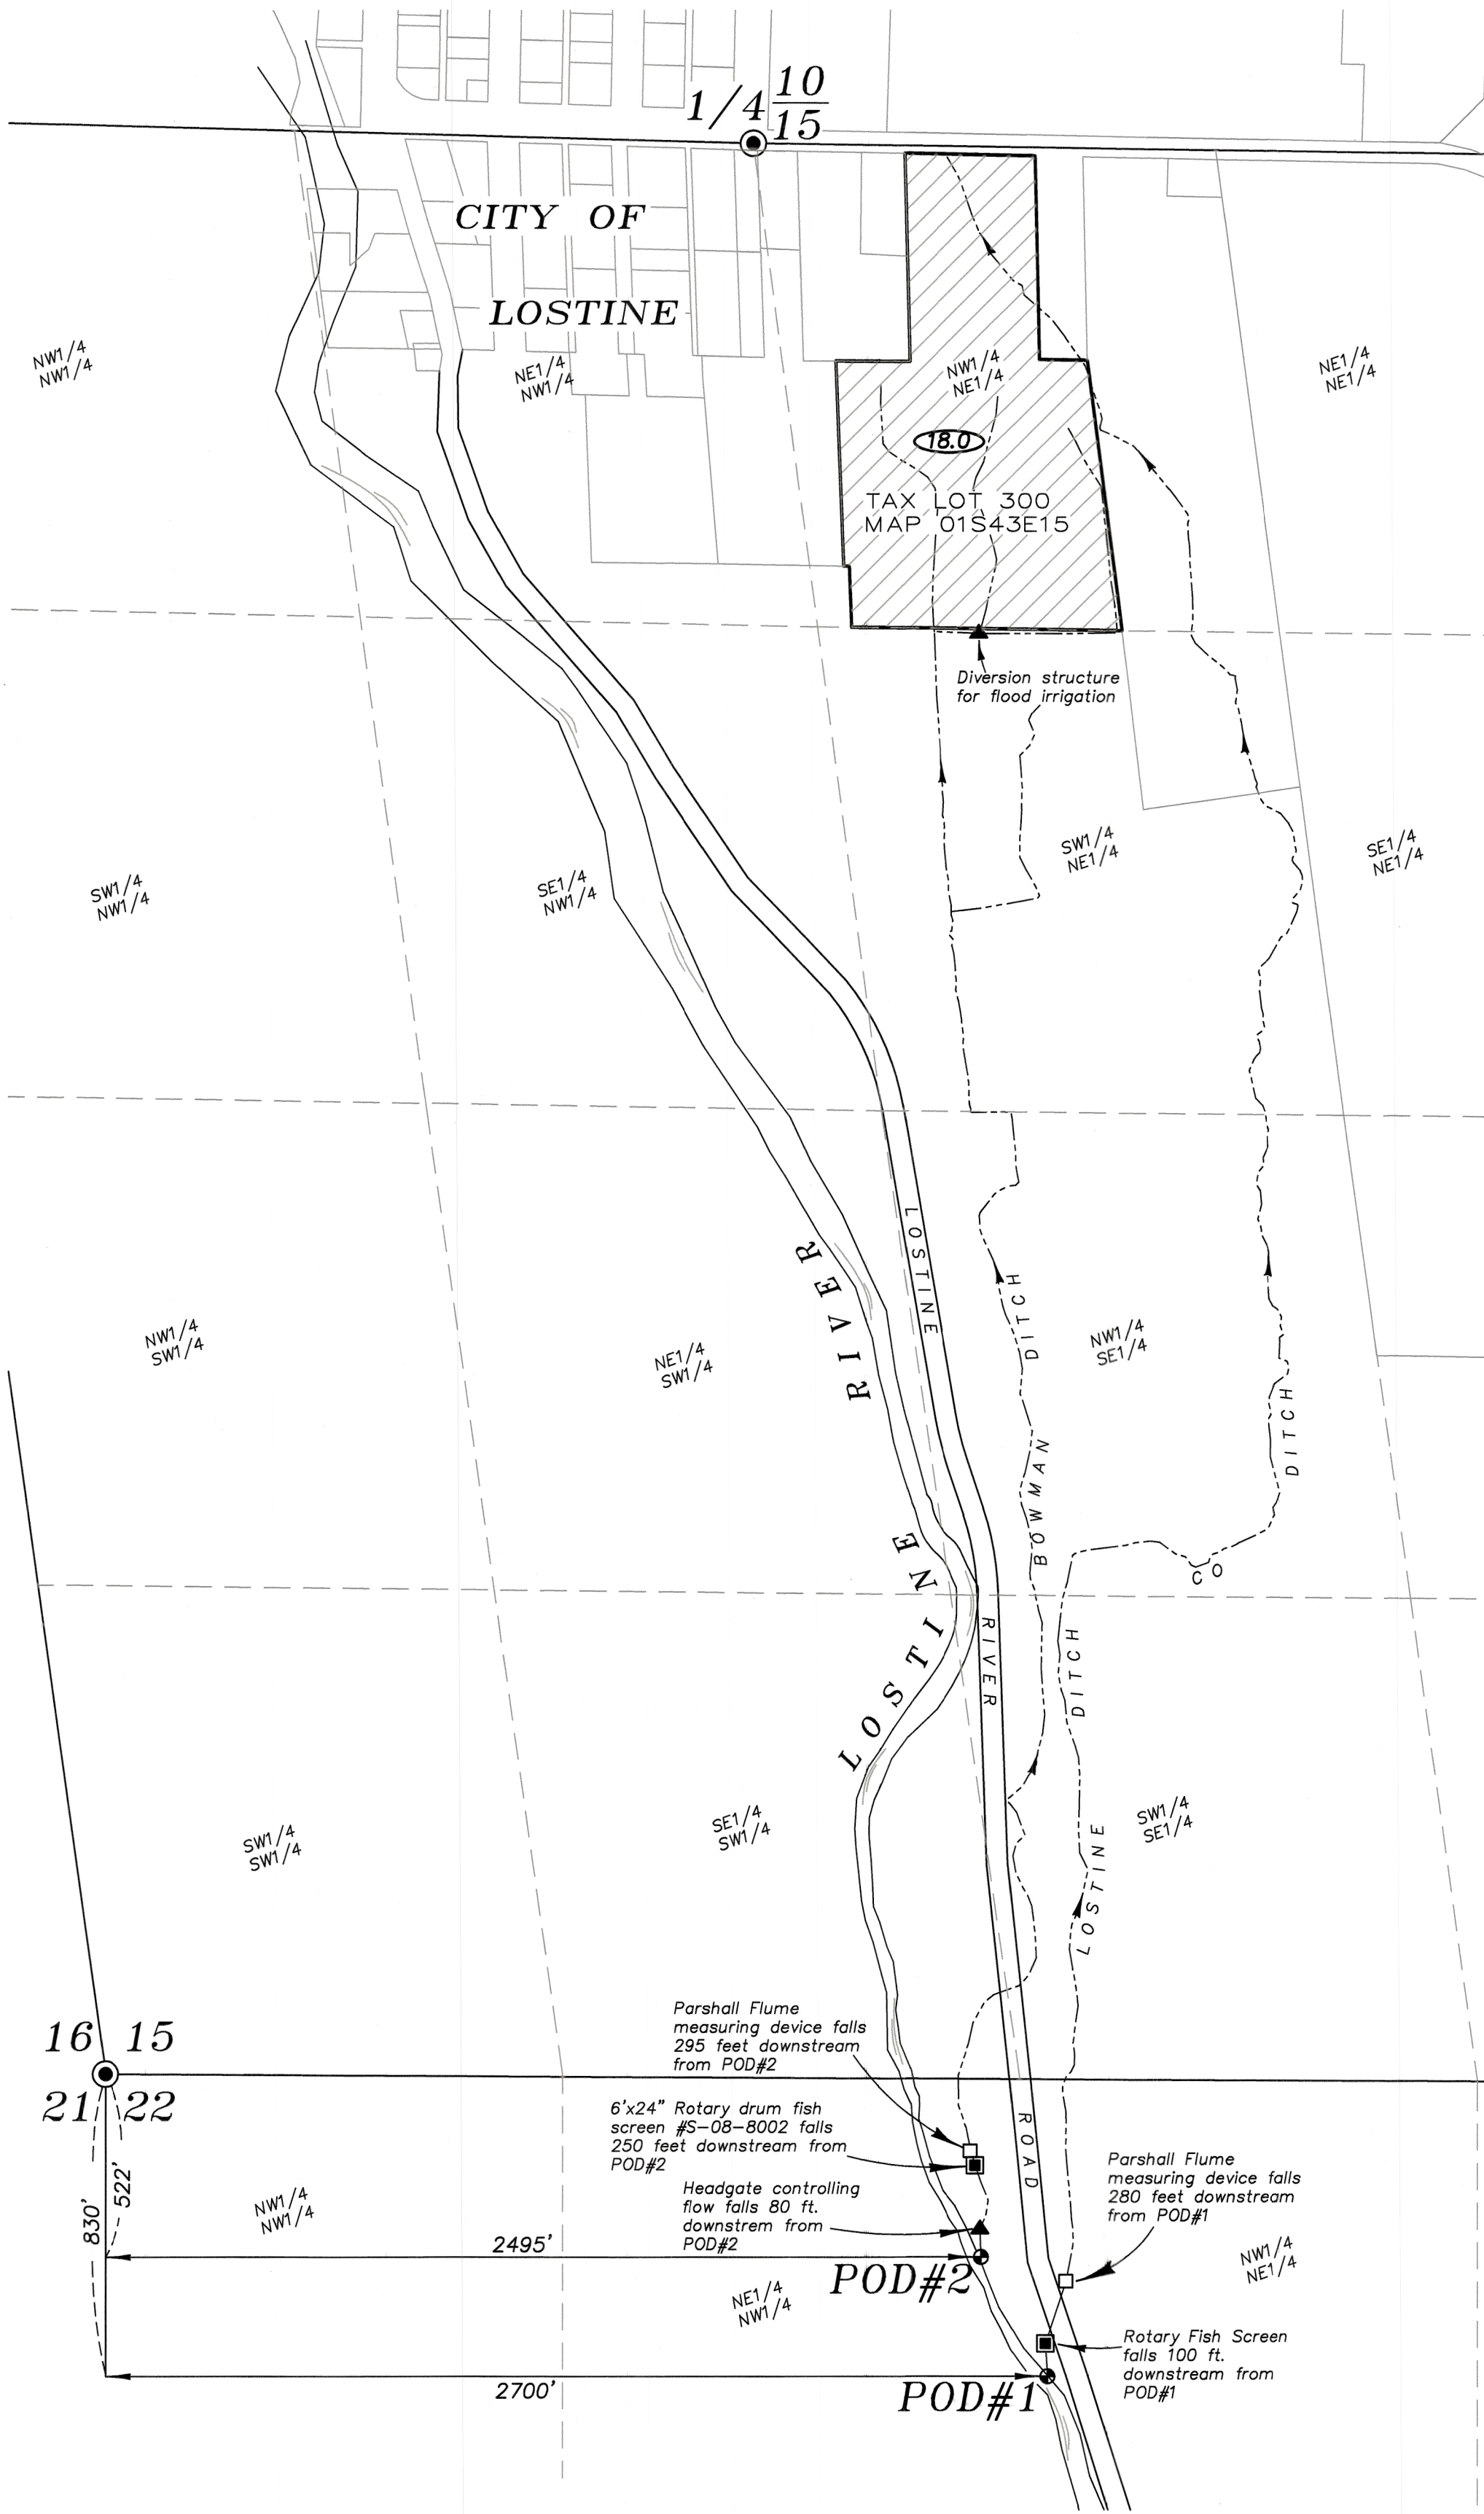

LEGEND

- Survey Monument
- ⦿ Point of Diversion
- ▲ Headgate
- Fish Bypass
- Parshall Flume



SCALE: 1"=400'

October 5, 2023
**CLAIM OF BENEFICIAL USE
 FOR AN ADDITIONAL POINT OF
 DIVERSION**
 FOR
CATHY JOHNSON

BY
BAGETT - GRIFFITH & BLACKMAN
 2006 ADAMS AVENUE
 LAGRANDE, OREGON 97850



NOTE: The preparation of this map was for the purpose of identifying the location of water rights and has no intent to provide dimensions or location of property ownership lines. Location information shown hereon was furnished by the applicant.

Renews: June 30, 2025

RECEIVED
 NOV 13 2023
 OWRD

APPLICATION NO. T-12603

PERMIT NO. _____