



Township 40S., Range 3W.

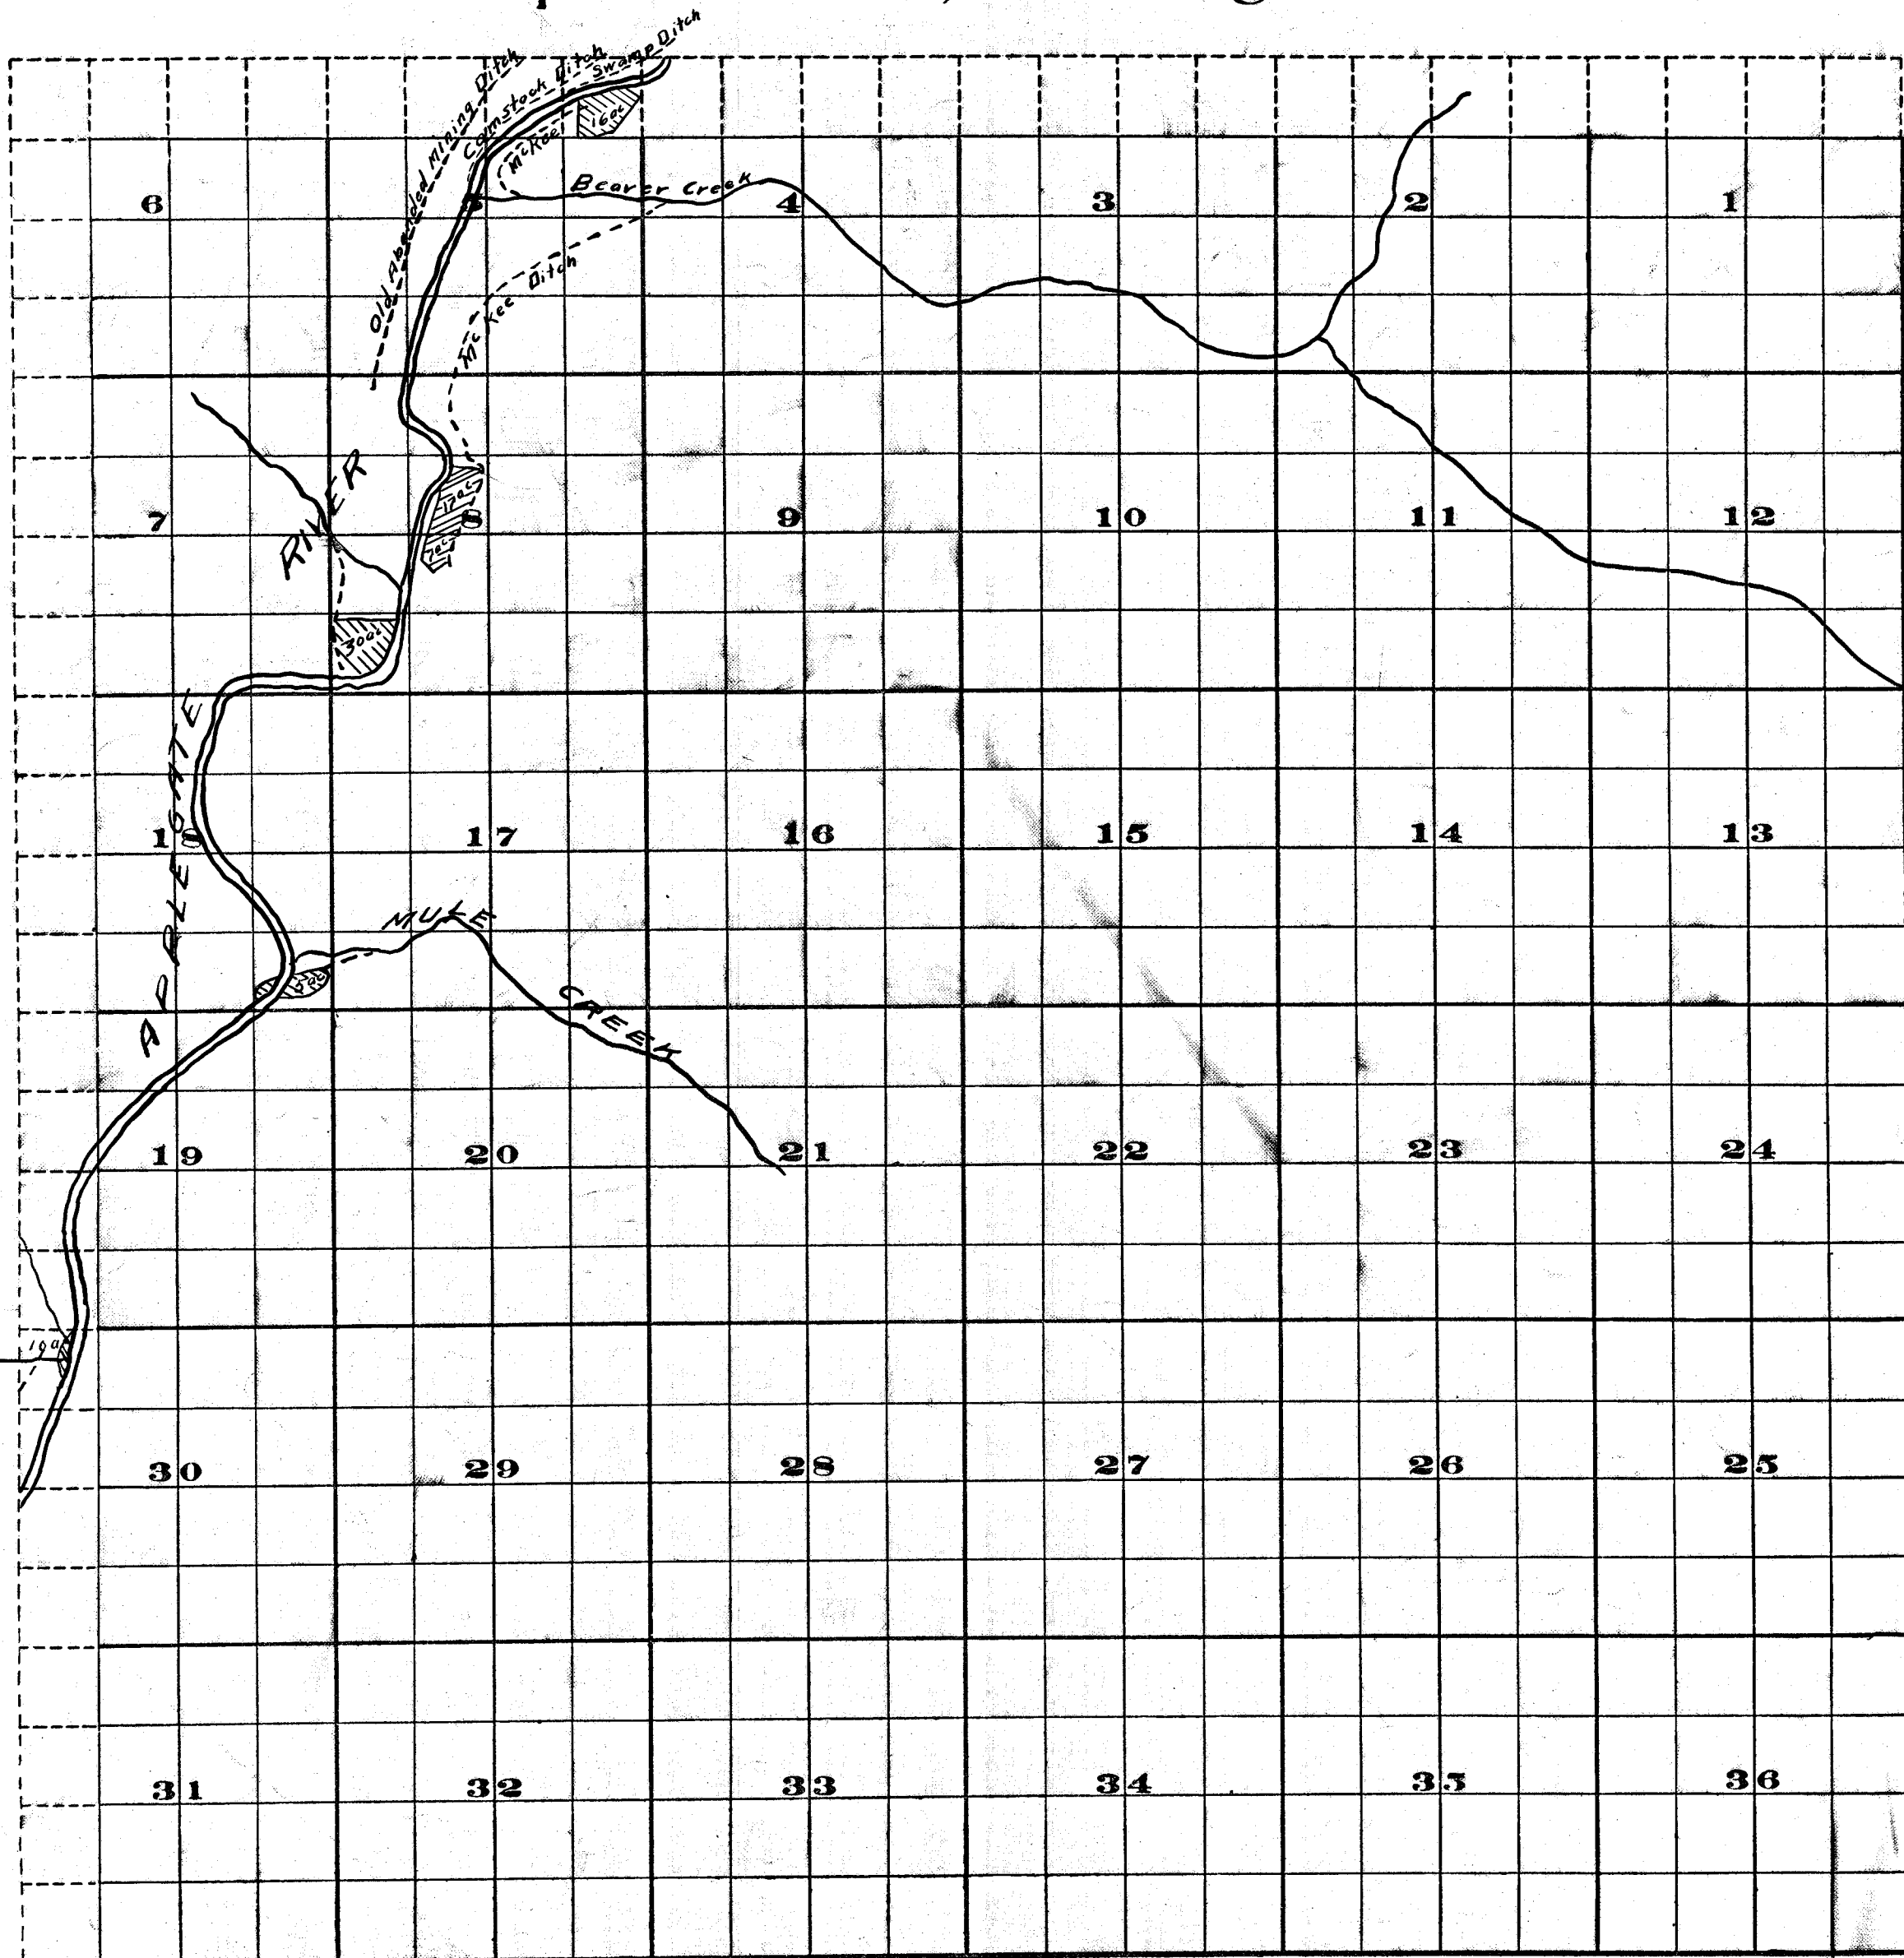

Survey by J.S. McMahon May 1910

FROM OFFICE OF THE STATE ENGINEER, SALEM, OREGON

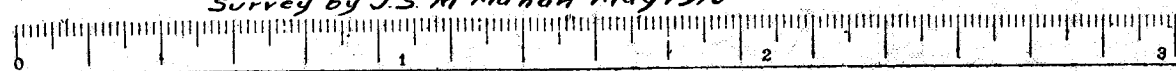

M. D.
D.F.M. 11/20-11

Scale of Feet.

Adjudication

Rogue River and Tributaries

John H. Lewis State Engr.

Examined Sept 18, 1911

40S. 3W.