


T. 27 S., R. 3 W., W. M.

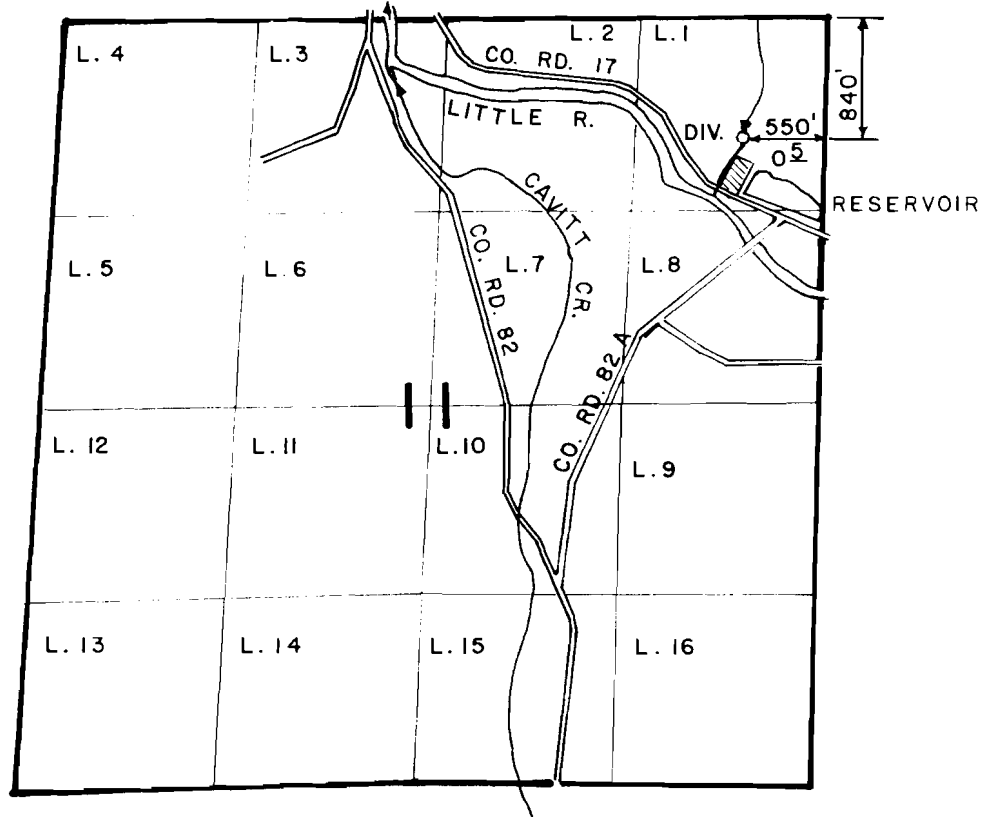

SCALE: 4" = 1 MILE

FINAL PROOF SURVEY UNDER

Application No. 56943 Permit No. 43542
IN NAME OF

MARY M. CHANDLER

Surveyed APR. 7 1988, by J. M. SCHMORDE
AUG. 27, 1991, B. S. JAMES