


# Claim of Beneficial Use - Spurlin

## Application G-18138, Permit G-17662

Township 13S, Range 3W, W.M.

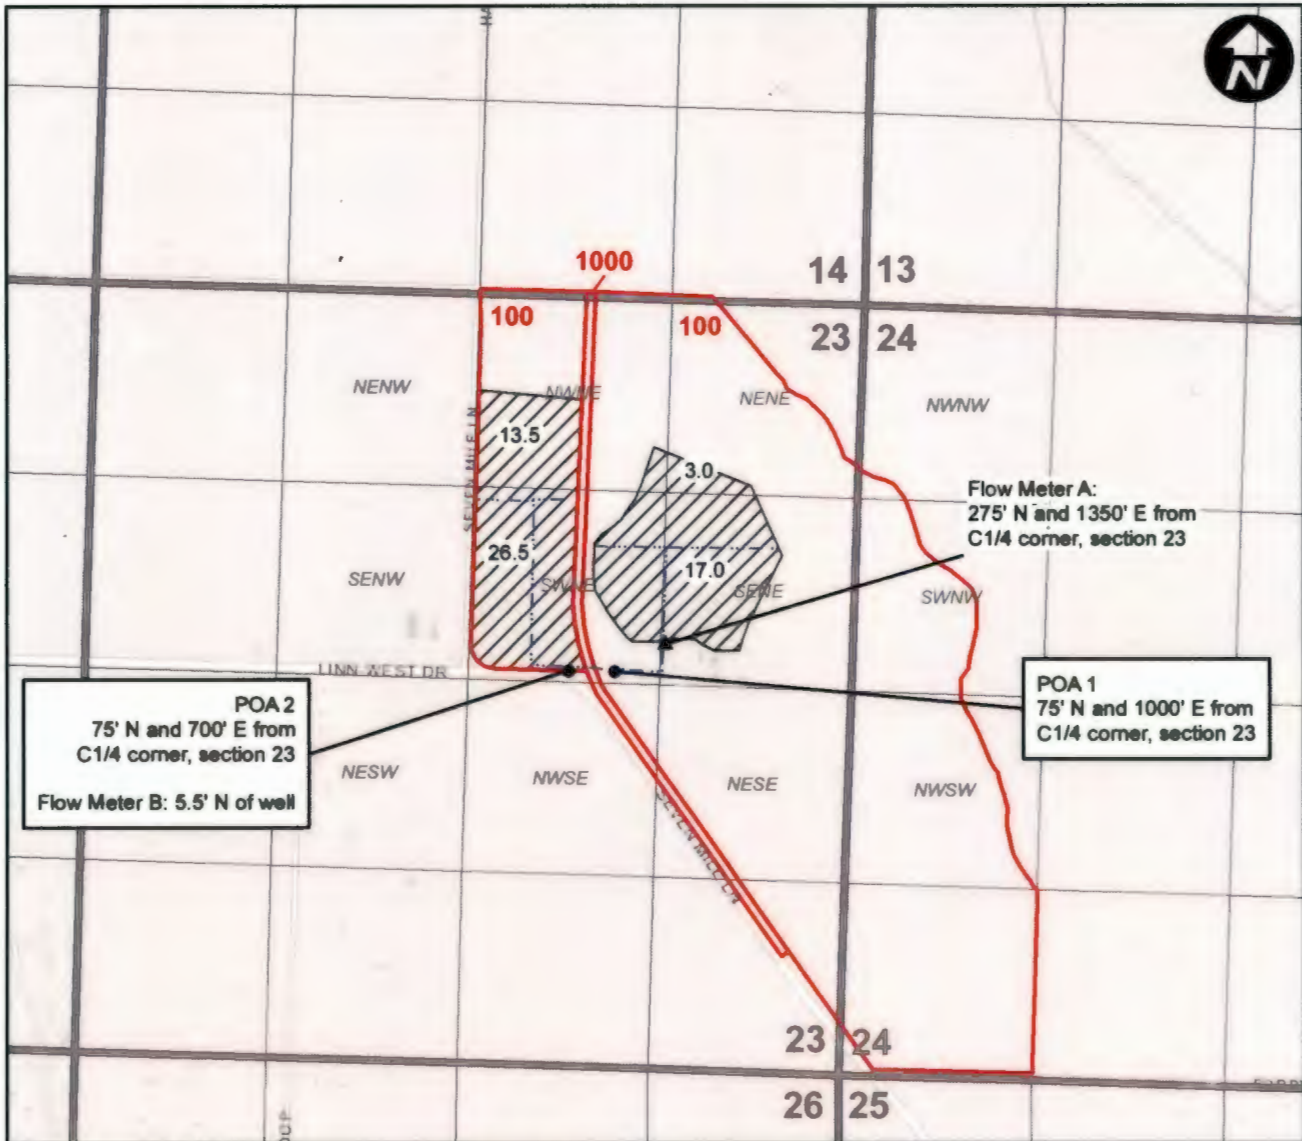

This map is not intended to provide legal dimensions or locations of property ownership lines.

0 660 1,320 2,640 Feet

### Legend

IR POU Mainline Taxlots



NOV 21 2023 EXPIRES: 12-31-2024