

Document Path: Y:\0254_Joint_Water_Commission\Source_Figures\024_W016_T4_Jackson_Bottom\COBU\COBU_R15295.mxd, Jramos

LEGEND


- ⊙ Point of Diversion (POD)
- Staff Gauge
- ▨ Place of Use (POU)
- Taxlot
- ⌈ Donation Land Claim (DLC)
- ⌈ Government Lot (GL)
- ~ Watercourse
- ~ Waterbody

**Claim of Beneficial Use Map
City of Hillsboro**

Application R-88419; Permit R-15295

Township 1 South, Range 2 West (W.M.)
Washington County

CERTIFIED WATER RIGHTS EXAMINER STAMP

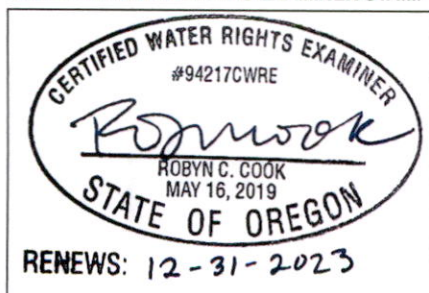

RECEIVED

NOV 21 2023

OWRD

POD LOCATION DESCRIPTION

Outlet
Located 1365 feet South and 1300 feet East from the NW corner of Section 7, Township 1 South, Range 2 West (W.M.)

DISCLAIMER
This map was prepared for the purpose of identifying the location of a water right only and it is not intended to provide legal dimensions or location of property ownership lines.

Date: November 1, 2023
Data Sources: BLM, ESRI, OWRD, USGS

