




LEGEND

- ⊙ Point of Diversion (POD)
- Staff Gauge
- ▨ Place of Use (POU)
- Tax Lot
- Donation Land Claim (DLC)
- Government Lot (GL)
- ~ Watercourse

POD LOCATION DESCRIPTION

Outlet (WCS 2)
 Located 607 feet North and 3409 feet East from the SW corner of Section 6, Township 1 South, Range 2 West (W.M.)

CERTIFIED WATER RIGHTS EXAMINER STAMP

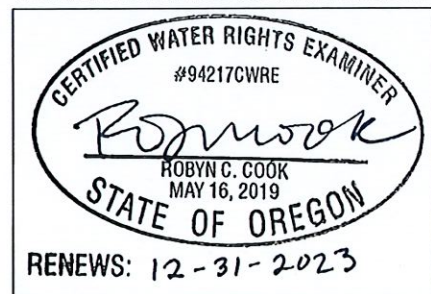

DISCLAIMER

This map was prepared for the purpose of identifying the location of a water right only and it is not intended to provide legal dimensions or location of property ownership lines.
 Date: November 1, 2023
 Data Sources: BLM, ESRI, OWRD, USGS

RECEIVED
 NOV 21 2023
 OWRD

**Claim of Beneficial Use Map
 City of Hillsboro**

Application R-88582; Permit R-15347
 Township 1 South, Range 2 West (W.M.)
 Washington County

