



# Oregon

Tina Kotek, Governor

## Water Resources Department

North Mall Office Building  
725 Summer St NE, Suite A  
Salem, OR 97301-1266  
Phone: 503-986-0900  
Fax: 503-986-0904  
[www.Oregon.gov](http://www.Oregon.gov) / OWRD

November 17, 2023

Maggie Davis  
Bonner Walsh  
PO Box 125  
Bly, OR 97622

Reference: Application G-8770, Permit G-8103

The partial assignment by proof from Michael G. and Carol L. O'Brion, and Creighton E. and Jeannette L. Bailey to Maggie Davis and Bonner Walsh has been recorded in the records of the Water Resources Department.

The Departments records will now show Michael G. and Carol L. O'Brion, Creighton E. and Jeannette L. Bailey, Maggie Davis, and Bonner Walsh as the permit holders of record.

Our records have been changed accordingly and the original request is enclosed. Receipt number 141840 covering the recording fee is also enclosed.

A permit is not a perfected water right and has conditions and timelines that must be satisfied prior to a Certificate of Water Right being issued. Please review the permit to be familiar with the conditions and timelines contained in the permit.

Sincerely,

Mary F. Bjork  
Water Rights Program Analyst  
Water Right Services Division

Enclosure: Original Request and Receipt 141840

cc: Data Center, OWRD (cover letter & request)  
File



# Request for Assignment By Proof of Ownership (If Water Right Holder is Not Available)



Oregon Water Resources Department  
725 Summer Street NE, Suite A  
Salem, Oregon 97301-1266  
(503) 986-0900  
[www.oregon.gov/owrd](http://www.oregon.gov/owrd)

If the Department determines that the application is incomplete, fees have not been paid, or the required documents are not acceptable, the application and all fees submitted will be returned to the applicant.

If for multiple rights, a separate form and fee for each right will be required.

I, Maggie Davis and Bonner Walsh  
(Name of Party Requesting Assignment)  
P.O. Box 125 Bly Or. 97622 325-~~226~~-3935  
(Mailing Address) (City) (State) (Zip) (Phone #)

- hereby request assignment of an entire application/permit/transfer order /limited license/groundwater statement;
- hereby request assignment of a portion of application/permit/transfer order/limited license/groundwater statement;  
(You must include a map showing the portion of the application/permit/ transfer order /limited license/groundwater statement to be assigned.)

Application # G-8770 ; Permit # G8103 ; Transfer Order # \_\_\_\_\_

Limited License # \_\_\_\_\_ ; Groundwater Statement # \_\_\_\_\_

MICHAEL G O'BRION, CAROL L O'BRION, CREIGHTON E & JEANETTE L BAILEY

(Name of Current Halder of Record)

1250 ATKINSON RD LODI CA 95240  
(Mailing Address) (City) (State) (Zip) (Phone #)

Note: Write the initials (first letters) of your first and last names at the spots indicated below \_\_\_\_\_.

- 1) m.D. I certify that I am the current owner of the property described in this application, permit, transfer order, limited license, or groundwater statement. I have attached proof of ownership that may include but not be limited to: a copy of the deed to the land, a copy of a land sales contract, a court order or decree, documentation of survivorship of property held jointly. The Department cannot accept a copy of a taxstatement.
- 2) \_\_\_\_\_ I have the legal right to request assignment under OAR 690-310-0280 and 690-320-0060.
- 3) m.D. I have not been able to contact the owner(s) of record for the above referenced transaction. I have attached proof acceptable to the Department that notice of the assignment has been given or attempted for each identified property owner not a party to the assignment. ORS 537.220(2) Failure to submit this proof will result in the return of your request. (Proof may include but not be limited to: a copy of returned certified mailing, copy of a Death Certificate, or a court order.)
- 4) \_\_\_\_\_ I further certify that the information provided herein is true and correct to the best of my knowledge.

Witness my hand this 31<sup>st</sup> day of October, 2023.  
(Day) (Month) (Year)

Signature of Party Requesting Assignment \_\_\_\_\_

Failure to provide any of the required information will result in the return of your application.

This certifies assignment and record change at Oregon Water Resources Department effective 8:00 a.m. on date of receipt at Salem, Oregon.

Fee receipt # 141840  
For Director by Mary F. Bjork, Program Analyst in Water Rights Division. MFB

The completed "Request for Assignment" form must be submitted to the Department along with the recording fee of \$120.

RECEIVED  
NOV 17 2023  
OWRD


RECEIVED  
NOV 01 2023  
OWRD

part. assign by proof - approve  
MFB 11-17-2023

RECEIVED  
 NOV 17 2023  
 OWRD

RECEIVED  
 APR 27 1978  
 WATER RESOURCES DEPT.  
 SALEM, OREGON

Application No. G-8710  
 Permit No. G-8103

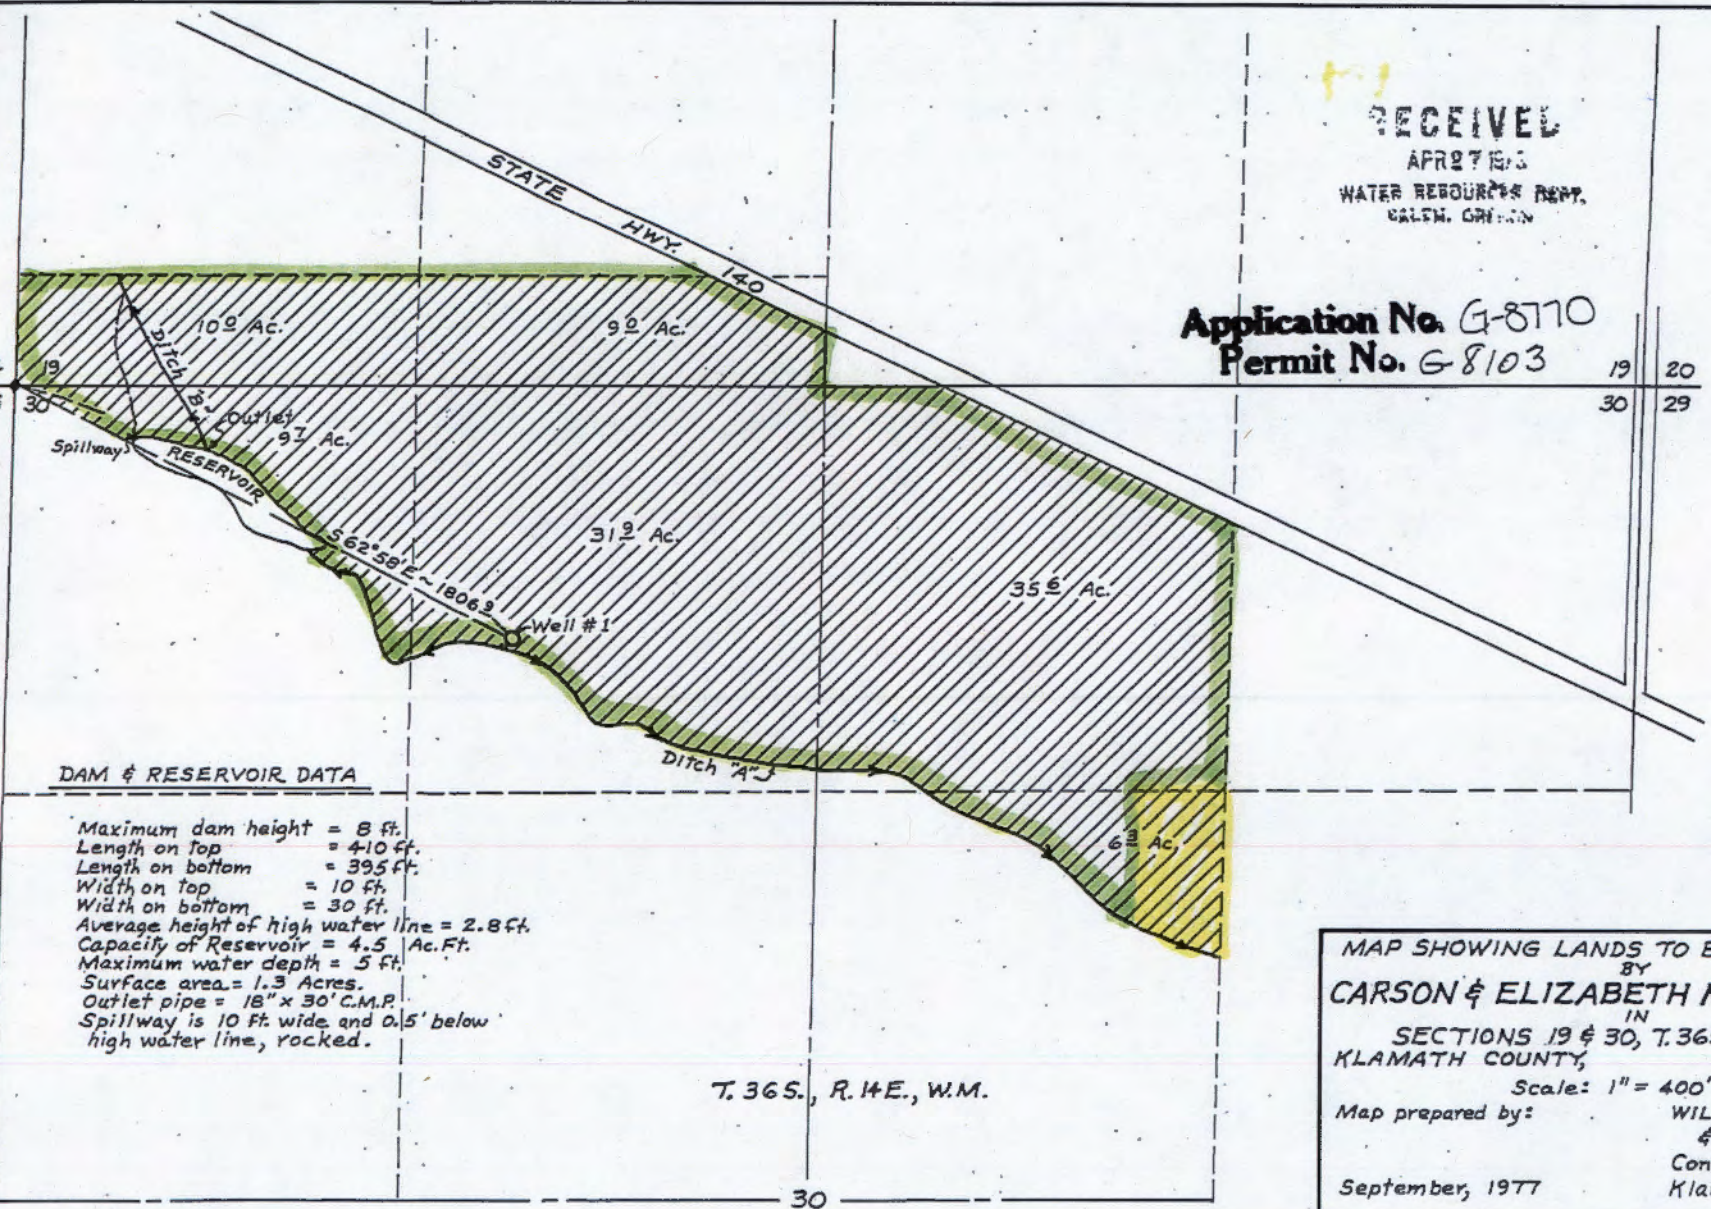

**DAM & RESERVOIR DATA**

Maximum dam height = 8 ft.  
 Length on top = 410 ft.  
 Length on bottom = 395 ft.  
 Width on top = 10 ft.  
 Width on bottom = 30 ft.  
 Average height of high water line = 2.8 ft.  
 Capacity of Reservoir = 4.5 Ac.Ft.  
 Maximum water depth = 5 ft.  
 Surface area = 1.3 Acres.  
 Outlet pipe = 18" x 30' C.M.P.  
 Spillway is 10 ft. wide and 0.5' below high water line, rocked.

T. 36S., R. 14E., W.M.

MAP SHOWING LANDS TO BE IRRIGATED  
 BY  
**CARSON & ELIZABETH M. MERKLEY**  
 IN  
 SECTIONS 19 & 30, T. 36S., R. 14E., W.M.  
 KLAMATH COUNTY, OREGON  
 Scale: 1" = 400'  
 Map prepared by: **WILLIAM L. WALES & Associates**  
 Consulting Engineers  
 Klamath Falls, Oregon  
 September, 1977

In the above map, the property that is not owned by us in in the lower right corner and is highlighted yellow. The area that is bounded by the green highlighting is the area for which we are requesting an assignment.